


**Department of Transportation  
and Public Facilities  
Southcoast Region**

**PROJECT No. 0106(036) ~ 80665**

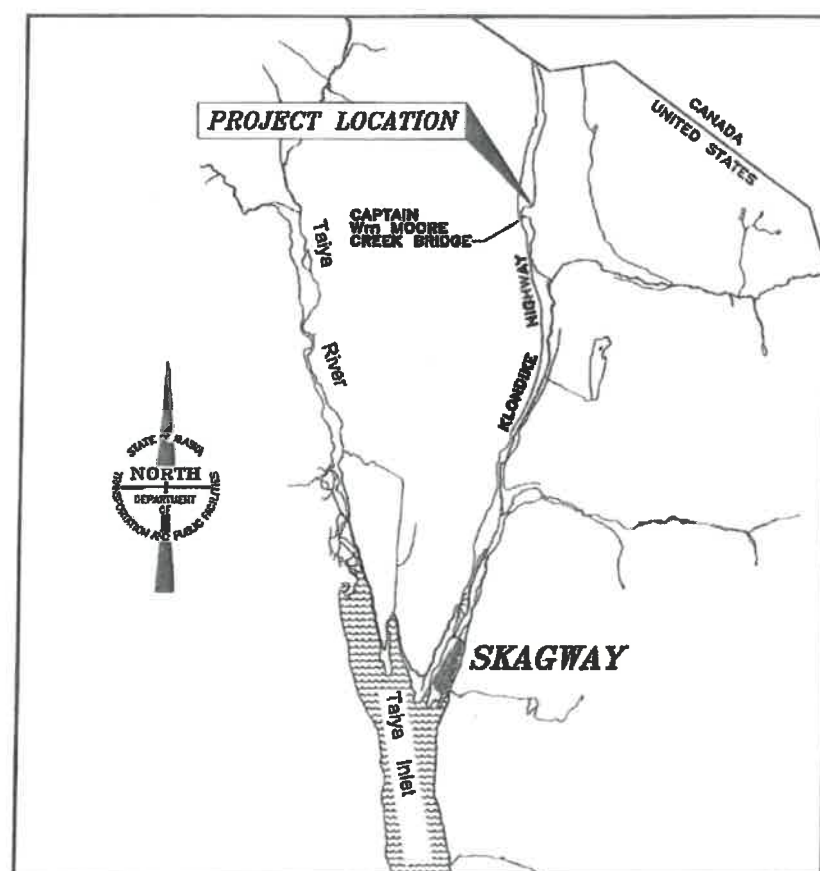

### VICINITY MAP


**NOTES:**

**Travel between Skagway and Mine Mountain job-site will require U. S. Border clearance.**

Use these plans in conjunction with the State of Alaska Standard Specifications for Highway Construction, 2015 edition and the project special provisions.

AS BUTZ  
JOHN ANDERSON  
7-12-17

[illegible]

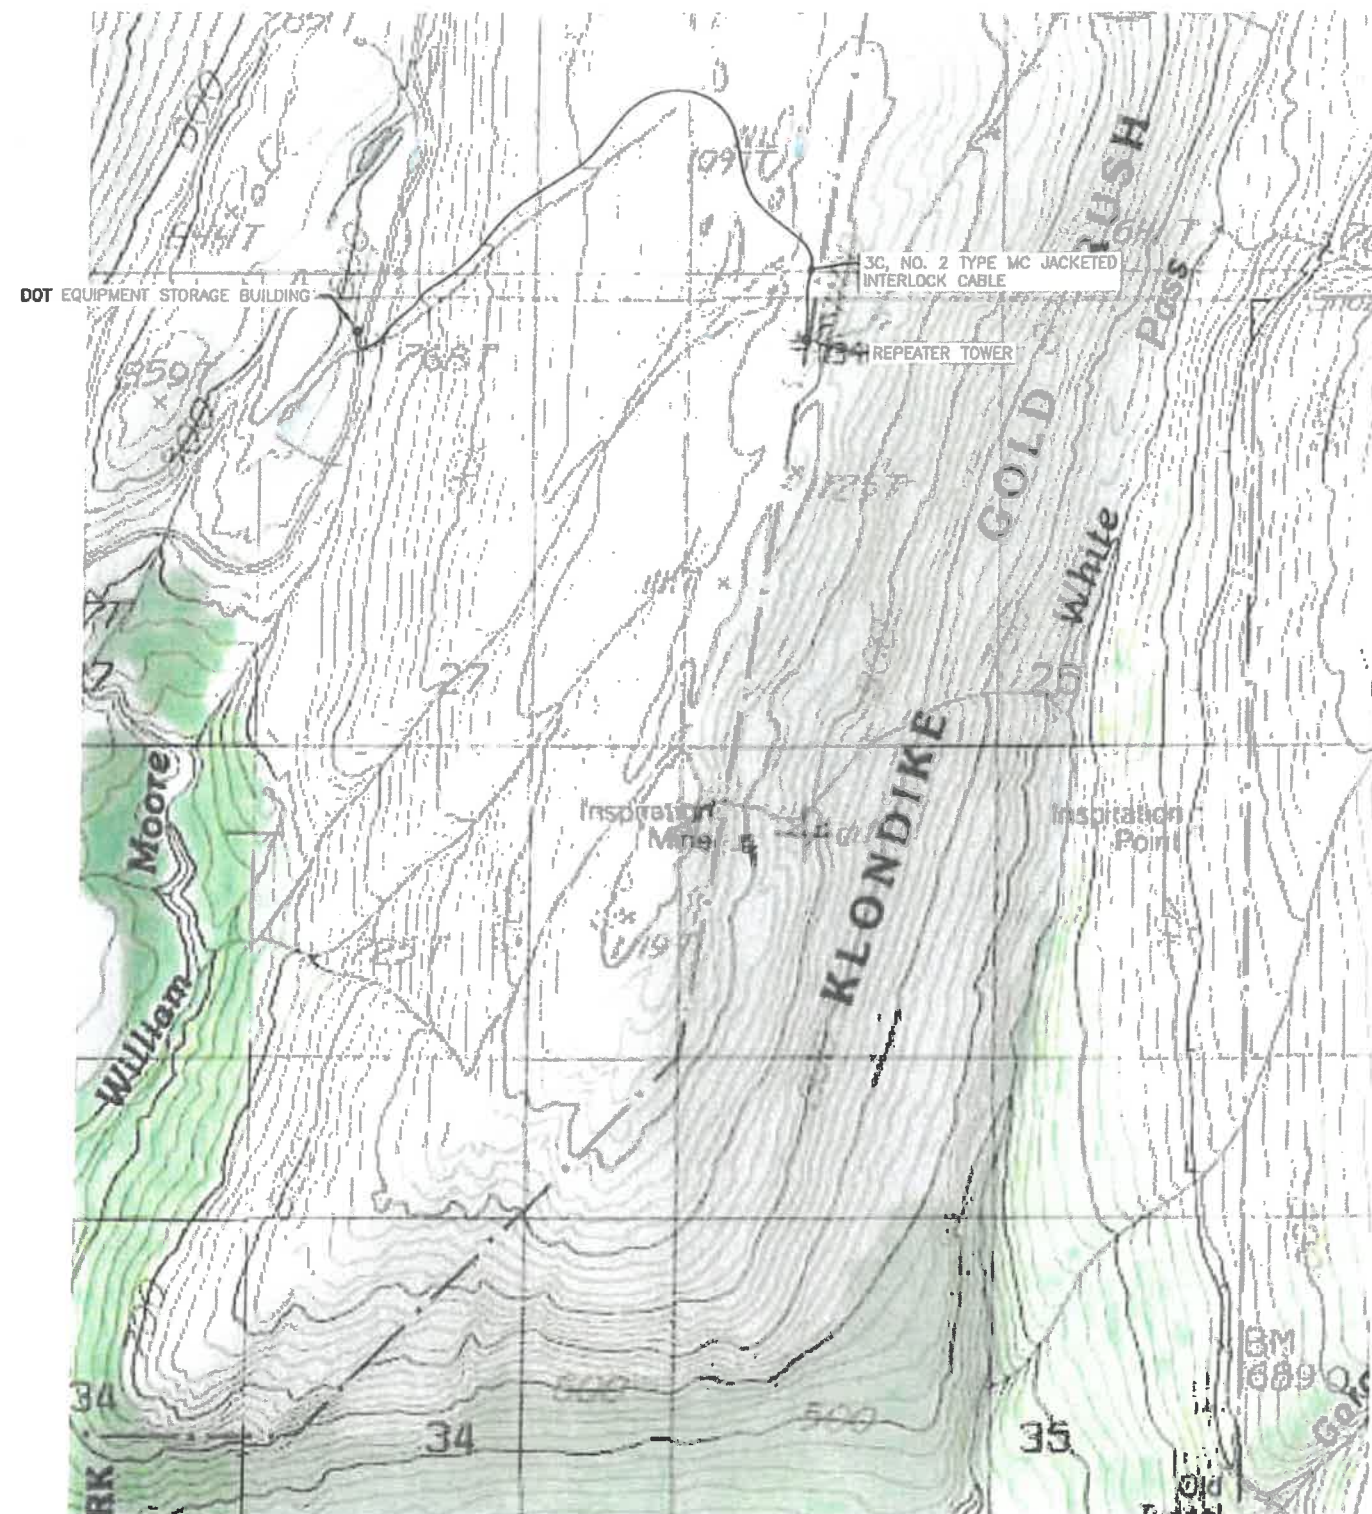

1 SITE PLAN

NO SCALE



## LEGEND

### ABBREVIATIONS:

UGE	UNDERGROUND ELECTRIC
HDG	HOT DIPPED GALVANIZED
PVC	POLYVINYL CHLORIDE CONDUIT, SHED. 80
RSC	RIGID STEEL CONDUIT
XFMR	TRANSFORMER
(E)	EXISTING
(N)	NEW

### LIGHTING:

(X)	EXTERIOR SOFFIT MOUNTED LUMINAIRE
-----	-----------------------------------

### POWER:

(D)	DUPLEX RECEPTACLE, 18" AFF UON.
(J)	JUNCTION BOX
(C)	CONDULET
(T)	TRANSFORMER
(P)	PANELBOARD
(G)	GROUND ROD
(B)	CIRCUIT BREAKER
(S)	SWITCH OR DISCONNECT
(F)	FUSE

## PROJECT NOTES

- THE CABLE ROUTE ILLUSTRATED IS APPROXIMATE. SELECT THE FINAL ROUTE TO PROVIDE THE BEST PROTECTION FOR THE CABLE.
- AVOID CROSSING ROCK BLUFFS, STEP GULLY, AND STREAMS.
- STAKE ROUTE, SPLICE LOCATIONS, AND ANCHOR LOCATIONS BEFORE PROCEEDING WITH CABLE INSTALLATION.
- CABLE ROUTE, SPLICE LOCATIONS, AND ANCHOR LOCATIONS SHALL BE APPROVED BY THE PROJECT ENGINEER.
- PULLOUT AT 12 MILE STATION MAY BE USED FOR STAGING. COORDINATE WITH MAINTENANCE MANAGER.
- PROJECT WORK SHALL NOT OCCUR IN THE KLONDIKE GOLD RUSH HISTORIC AREA.

STATE OF ALASKA  
DEPARTMENT OF TRANSPORTATION  
AND PUBLIC FACILITIES

## MINE MOUNTAIN REPEATER

SITE PLAN  
& LEGEND

CHECKED BY: BCH

DESIGNED BY: BCH/KHD

DRAWN BY: KHD

PROJECT DESIGNATION

0108(038)/80685


STATE	YEAR	SHEET
ALASKA	2015	B1 12





BASIS OF ESTIMATE		
662(1) ELECTRICAL POWER AND PHOTOVOLTAIC SYSTEM		
POWER DISTRIBUTION DEVICES		
DESCRIPTION	QUANTITY	PAY UNIT
INVERTER/CHARGER CHASIS	1	EA
CHARGE CONTROLLER	1	EA
BATTERIES (12V, 200AH)	4	EA
BATTERY ENCLOSURE	1	EA
SOLAR PANELS (22.1V, 140W)	3	EA
REPAIR & REORIENTATION OF EXISTING SOLAR PANEL STRUCTURE	1	LS
WORK LIGHT	1	EA
TOWER SUPPORT STRUCTURES	1	LS
POWER SHELTER SUPPORT STRUCTURES	1	LS
4-IN RIGID STEEL CONDUIT (SPLICE STRUCTURES)	5	EA
ROCK ANCHOR	<del>10</del> 12	EA
LUTIFY POLE	<del>1</del>	EA
MISC ITEMS	1	LS
RACEWAYS, CONDUCTORS AND CABLES		
3/4-IN GALV RIGID STEEL CONDUIT	10	LF
2-IN GALV RIGID STEEL CONDUIT	30	LF
1-1/4-IN EMT CONDUIT	30	CLF
2-IN PVC CONDUIT	<del>300</del> 350	LF
TRENCHING AND BACKFILL	300	LF
2-IN CONDUIT SUPPORTS	<del>9</del> 13	EA
JUNCTION BOXES	<del>2</del> 1	EA
NO. 12 XHHW	3	CLF
NO. 10 XHHW	0.2	CLF
NO. 8 XHHW	0.5	CLF
NO. 6 XHHW	<del>0.4</del> 0.7	CLF
NO. 4 XHHW	0.4	CLF
NO. 2 XHHW	0.05 0.1	CLF
1C, NO. 6 TYPE SCOW CABLE	0.03	MLF
1C, NO. 2 TYPE W CABLE	0.01	MLF
1C, NO. 2/0 TYPE W CABLE	0.02	MLF
3C, NO. 4 TYPE W CABLE	0.075	MLF
3C, NO. 10 TYPE SCOW CABLE	0.04	MLF
3C, NO. 6 TYPE SCOW CABLE	0.035	MLF
3C, NO. 6 TYPE MC JACKETED	0.1	MLF
3C, NO. 2 TYPE MC JACKETED	7	MLF

ESTIMATE OF QUANTITIES			
ITEM	DESCRIPTION	QUANTITY	PAY UNIT
640(1)	MOBILIZATION AND DEMOBILIZATION	1	LS
640(4)	WORKER MEALS AND LODGING, OR PER DIEM	1	LS
641(1)	EROSION, SEDIMENT, AND POLLUTION CONTROL, ADMINISTRATION	1	LS
641(3)	TEMPORARY EROSION, SEDIMENT AND POLLUTION CONTROL	1	LS
641(5)	TEMPORARY EROSION, SEDIMENT AND POLLUTION CONTROL BY DIRECTIVE	1	CS
641(6)	WITHHOLDING	1	CS
643(2)	TRAFFIC MAINTENANCE	1	LS
643(15)	FLAGGING	1	CS
643(25)	TRAFFIC CONTROL	1	CS
662(1)	ELECTRICAL POWER AND PHOTOVOLTAIC SYSTEM	1	LS

DO NOT SCALE FROM THESE DRAWINGS USE DIMENSIONS

07/16 UPDATE BASIS OF ESTIMATE		STATE OF ALASKA DEPARTMENT OF TRANSPORTATION & PUBLIC FACILITIES SOUTHEAST REGION	
CHECKED BY: BCH		SGY: MINE MOUNTAIN REPEATER POWER SYSTEM UPGRADE	
		ESTIMATE OF QUANTITIES & BASIS OF ESTIMATE	
DESIGNED BY: KHD			
DRAWN BY: REJ			
PATH: F:\PROJECTS\134 STATE OF ALASKA DOT\PR125A NINE MOUNTAIN REPEATER MODIFIED DESIGN\DRAWINGS\WORKING			
TAB: C1 Monday, July 25, 2016 12:33:15 PM ROBBIE JENSEN			
REVISIONS		PROJECT DESIGNATION	YEAR
NO.	DATE	DESCRIPTION	
		0106(036)/80665	2015
		SHEET NO.	TOTAL SHEETS
		C1	12

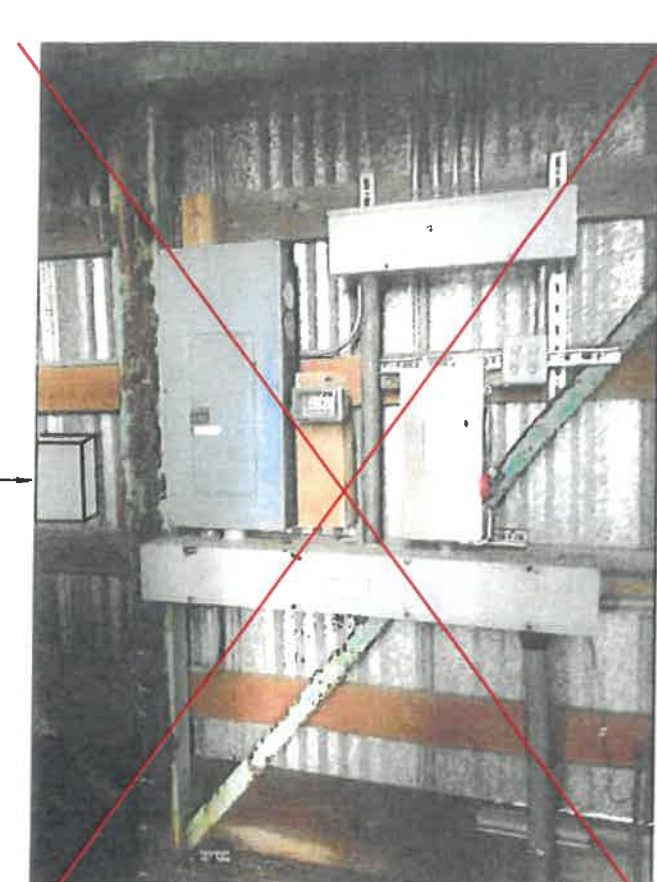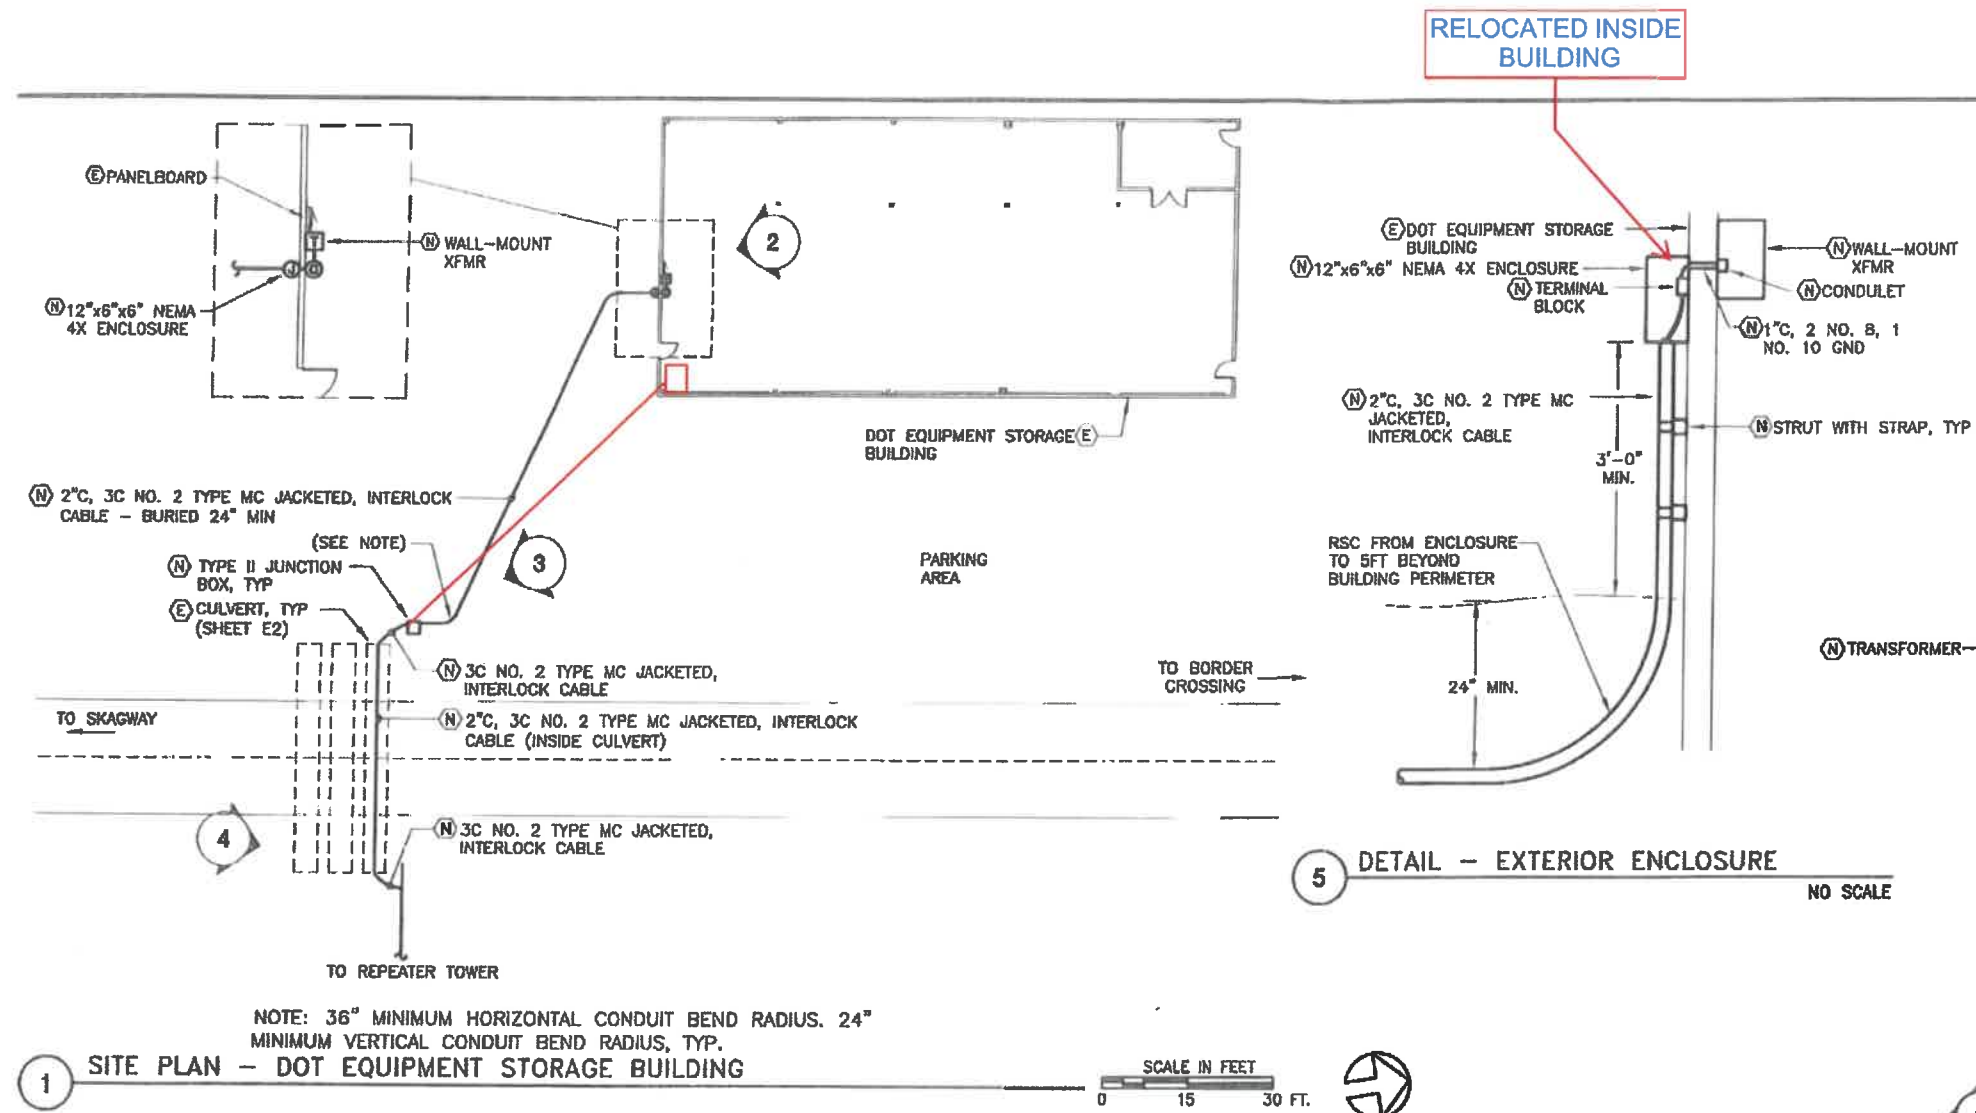

② **PHOTO – EXISTING PANELBOARD** NO SCALE



③ **PHOTO – EXISTING CULVERTS – WEST END** NO SCALE



④ **PHOTO – EXISTING CULVERTS – EAST END** NO SCALE

06/18 ELIMINATE HANDHOLE

STATE OF ALASKA  
DEPARTMENT OF TRANSPORTATION  
AND PUBLIC FACILITIES

SGY: MINE MOUNTAIN  
REPEATER POWER  
SYSTEM UPGRADE


**SITE PLAN  
& DETAILS**

CHECKED BY: BCH  
DESIGNED BY: BCH/KHD  
DRAWN BY: KHD


PROJECT DESIGNATION  
0108(038)/80865

STATE	YEAR	SHEET
ALASKA	2016	E1 12



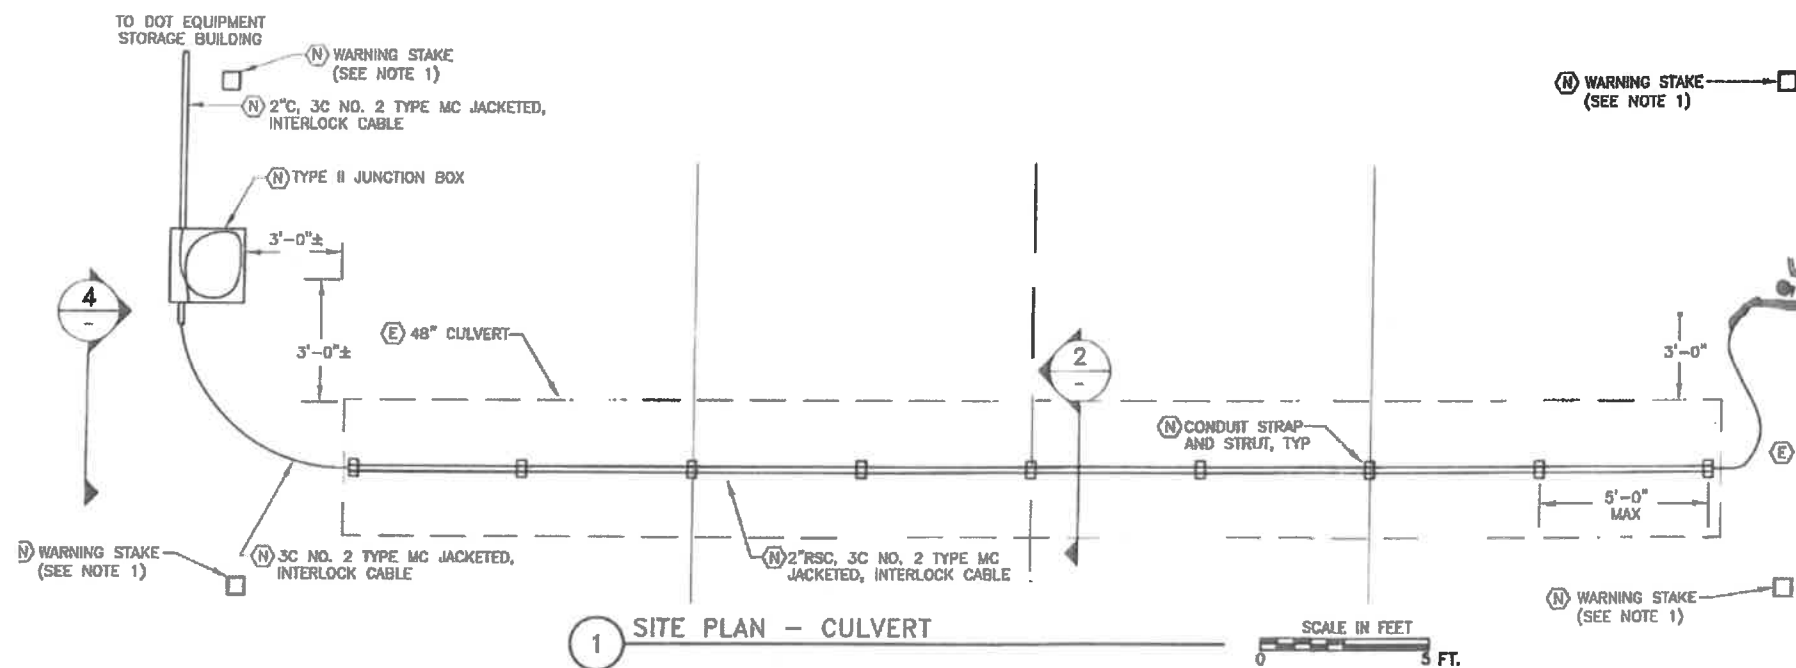



Install 2 cable anchors  
(1 on either side of ditch).  
See Sht E3, detail 3

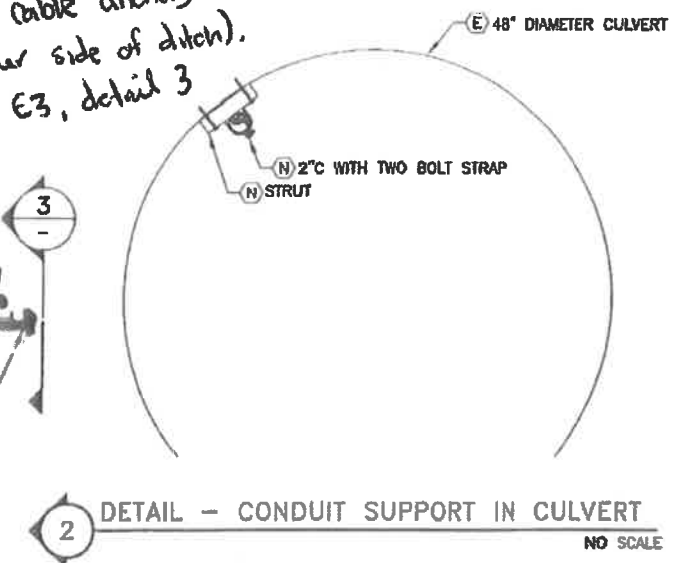

#### NOTES

1. CABLE GRIPS TO BE STAINLESS STEEL LACE-ON TYPE.
2. 5/8" EYE BOLT BOLTED TO CULVERT WITH CABLE GRIP ATTACHED TO CABLE SHALL BE USED ON BOTH SIDES OF EXISTING CULVERT.
3. TOP OF UNDERGROUND CONDUIT SHALL BE SEALED WATERTIGHT.
4. BUSHINGS TO BE ATTACHED TO EACH END OF CONDUIT INSIDE CULVERT. ALLOW FOR DRAINAGE OF WATER FROM SAID CONDUIT.
5. WRAP ANTI-CHAFFING SLEEVES AROUND ELECTRICAL CABLE AT CHAFFING PRONE AREAS.
6. REDIRECT FLOW OF WATER AS NEEDED DURING CONSTRUCTION.
7. WARNING STAKES SHALL BE REFLECTIVE TYPE, AND LABELED "CAUTION - BURIED ELEC LINE."

~~WARNING STAKES SHALL BE REFLECTIVE TYPE OR EQUIVALENT SHALL BE USED TO MARK THE LOCATION OF THE CONDUIT. THE STAKES SHALL BE LABELED "CAUTION - BURIED ELEC LINE." STAKES TO BE PLACED AT BOTH ENDS OF CONDUIT TO RUN IT IN PLACE.~~

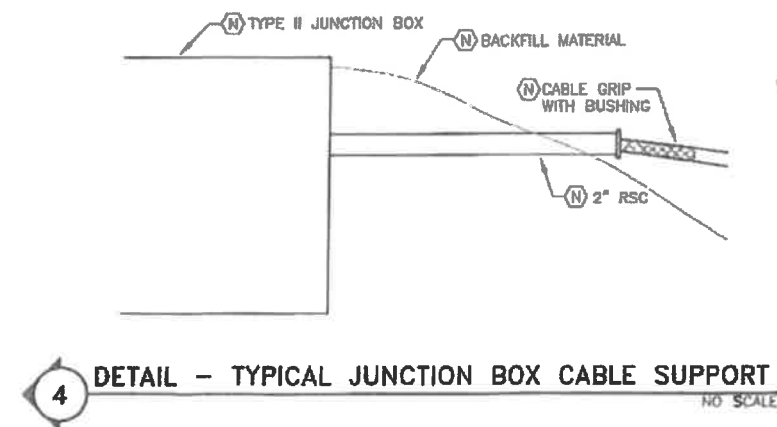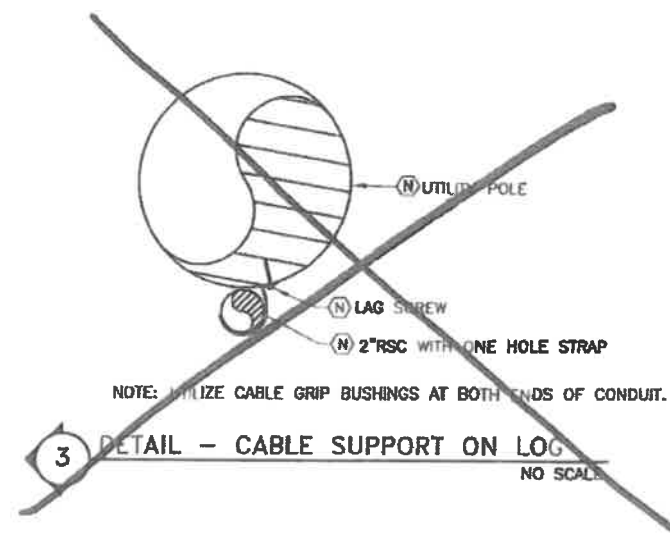

07/16 ELIMINATE HANDHOLE

STATE OF ALASKA  
DEPARTMENT OF TRANSPORTATION  
AND PUBLIC FACILITIES

SGY: MINE MOUNTAIN  
REPEATER POWER  
SYSTEM UPGRADE

SITE PLAN  
& DETAILS

CHECKED BY: BCH

DESIGNED BY: BCH/KHD

DRAWN BY: KHD


PROJECT DESIGNATION

0108(036)/80685

STATE YEAR SHEET

ALASKA 2015 E2 12



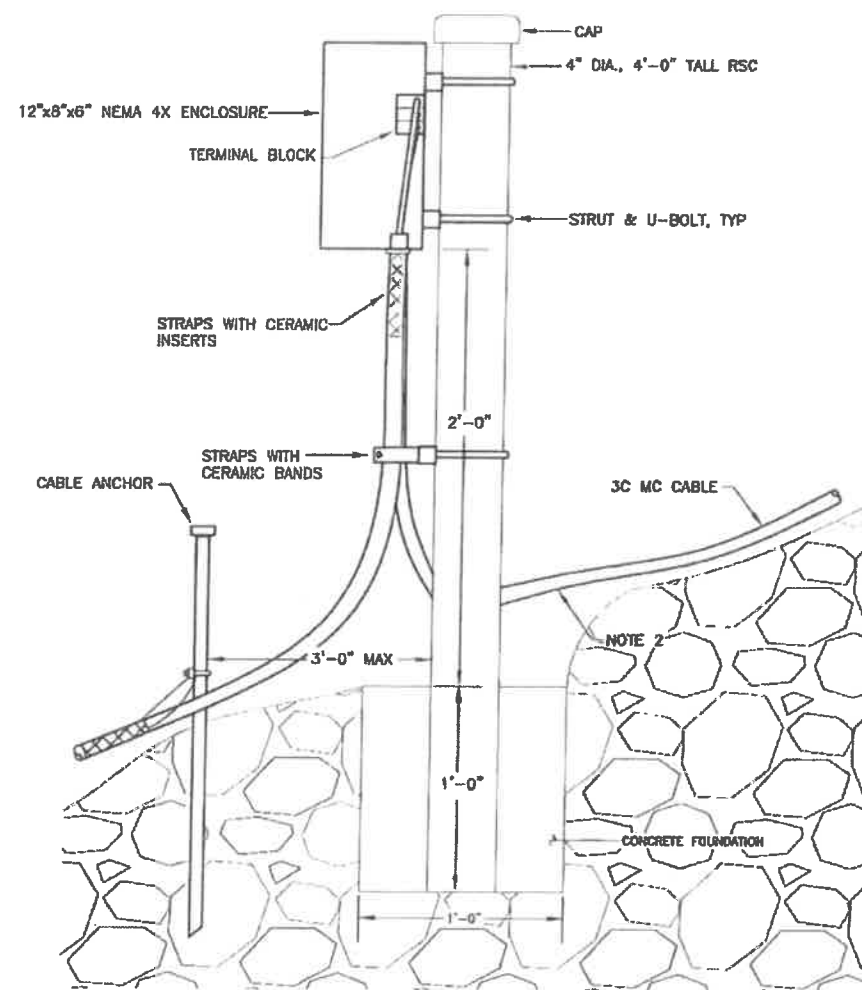


#### NOTES

1. SPLICES SHALL BE PLACED 1500 FEET APART, MINIMUM.
2. PROVIDE 3'-0" CABLE SLACK ABOVE SPLICE.
3. CABLE GRIPS SHALL BE STAINLESS STEEL LACE-ON TYPE.

#### DETAIL - CABLE SPLICE BOX

NO SCALE

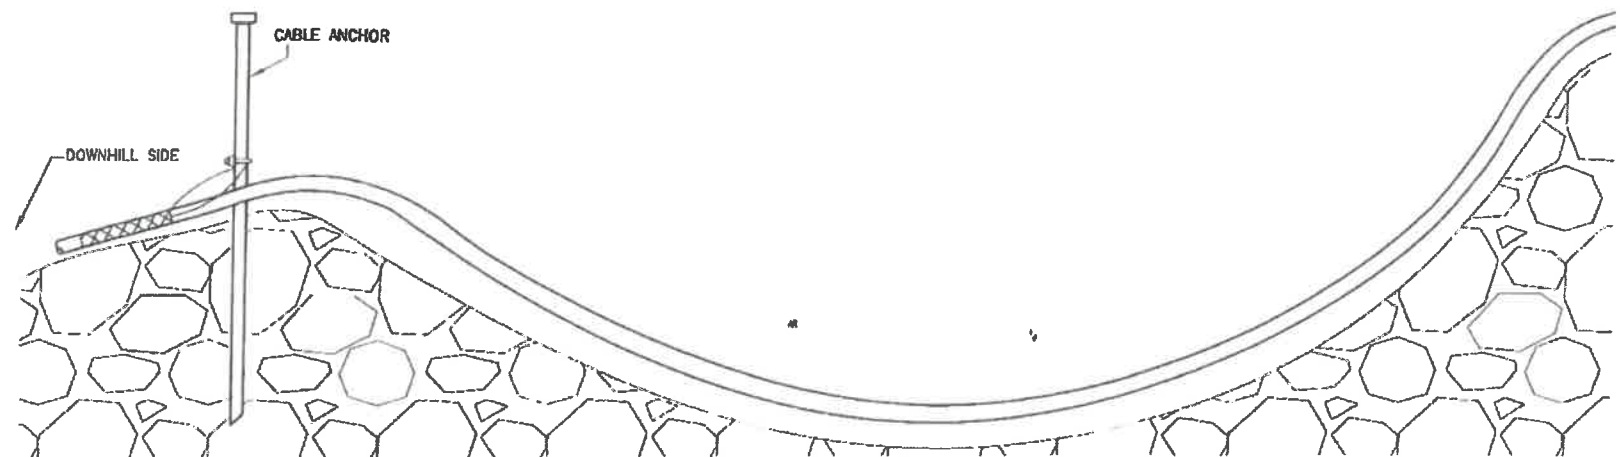


#### NOTES

1. CABLE ANCHOR SHALL BE PLACED AT DOWNHILL SIDE OF RAVINE AS SHOWN.
2. PROVIDE CABLE SLACK TO ALLOW CABLE TO LAY ON BOTTOM OF RAVINE.
3. CABLE GRIPS SHALL BE STAINLESS STEEL LACE-ON TYPE.

#### DETAIL - CABLE RAVINE SUPPORT

2

NO SCALE

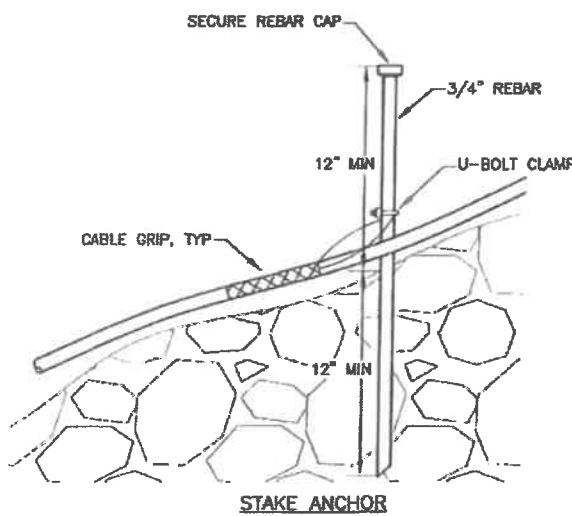


#### NOTES

1. INSTALL CABLE ANCHORS WHERE CABLE PATH CHANGES DIRECTION.
2. INSTALL CABLE ANCHORS NOT MORE THAN 250 FEET APART.
3. ANCHORS MAY BE STAKE OR ROCK ANCHOR TYPE. PROJECT ENGINEER WILL CONFIRM STABILITY OF BOULDERS FOR ROCK ANCHOR TYPES.
4. CABLE GRIPS TO BE STAINLESS STEEL LACE-ON TYPE.

#### DETAILS - MC CABLE ANCHORS

3

NO SCALE

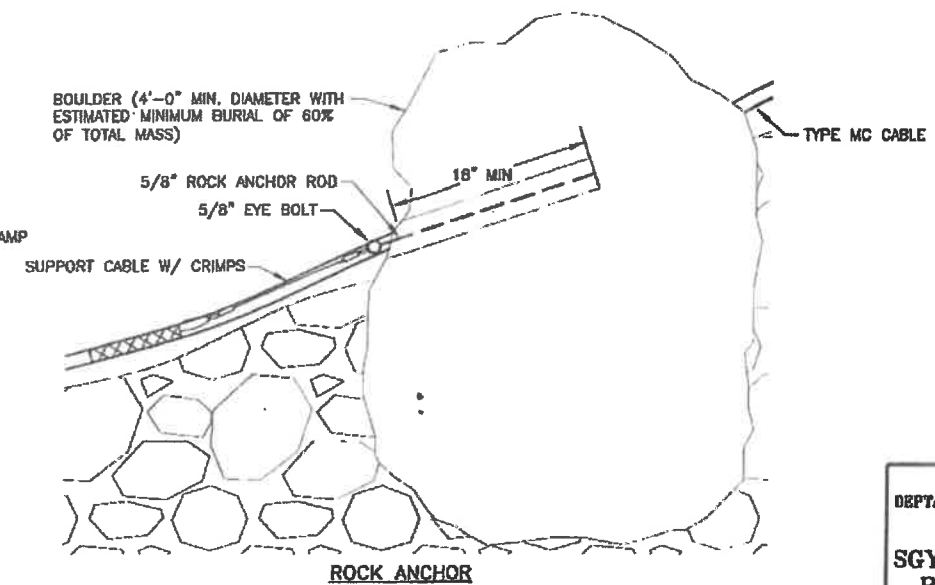

STATE OF ALASKA  
DEPARTMENT OF TRANSPORTATION  
AND PUBLIC FACILITIES  
SGY: MINE MOUNTAIN  
REPEATER POWER  
SYSTEM UPGRADE


#### SITE PLAN & DETAILS

CHECKED BY: BCH  
DESIGNED BY: BCH/KHD  
DRAWN BY: KHD

PROJECT DESIGNATION  
0108(038)/80885

STATE	YEAR	SHEET
ALASKA	2016	ES 12



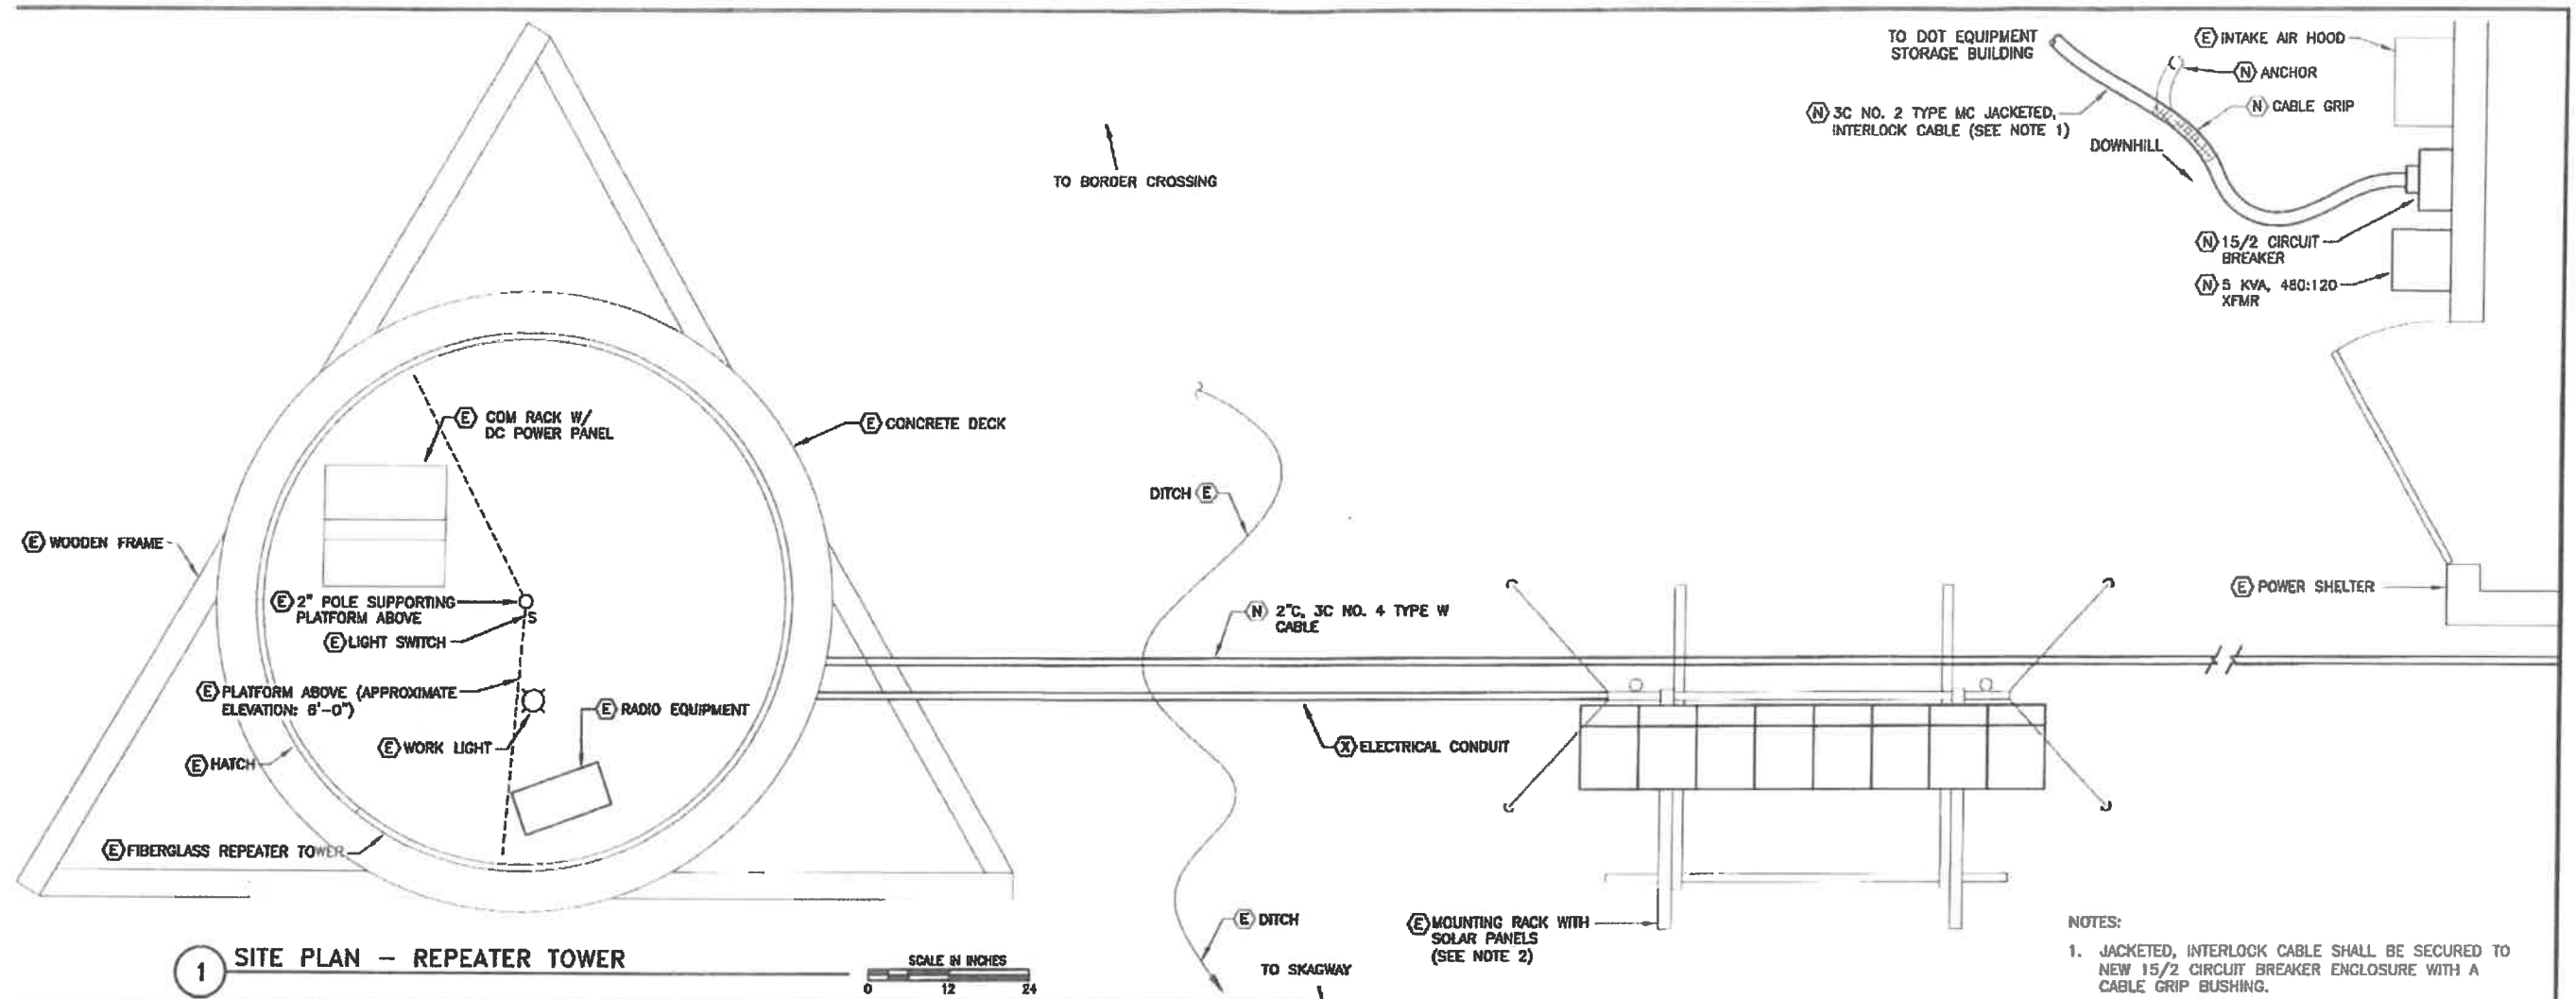

2 PHOTO - EXISTING REPEATER TOWER AND SOLAR PANELS


NOTE: REMOVE EXISTING SOLAR PANELS ON EXISTING FIBERGLASS REPEATER TOWER.

NO SCALE




06/16	INCORPORATE POWER SHELTER
STATE OF ALASKA DEPARTMENT OF TRANSPORTATION AND PUBLIC FACILITIES SGY: MINE MOUNTAIN REPEATER POWER SYSTEM UPGRADE SITE PLAN & DETAILS	
CHECKED BY: BCH	
DESIGNED BY: BCH/KHD	
DRAWN BY: KHD	
PROJECT DESIGNATION	
0108(036)/80865	
STATE	YEAR
ALASKA	2015
SHEET	
E4	12

SEE ATTACHED  
ONE LINE AS-BUILT  
FOR CONDUIT AND  
CONDUCTOR SIZES

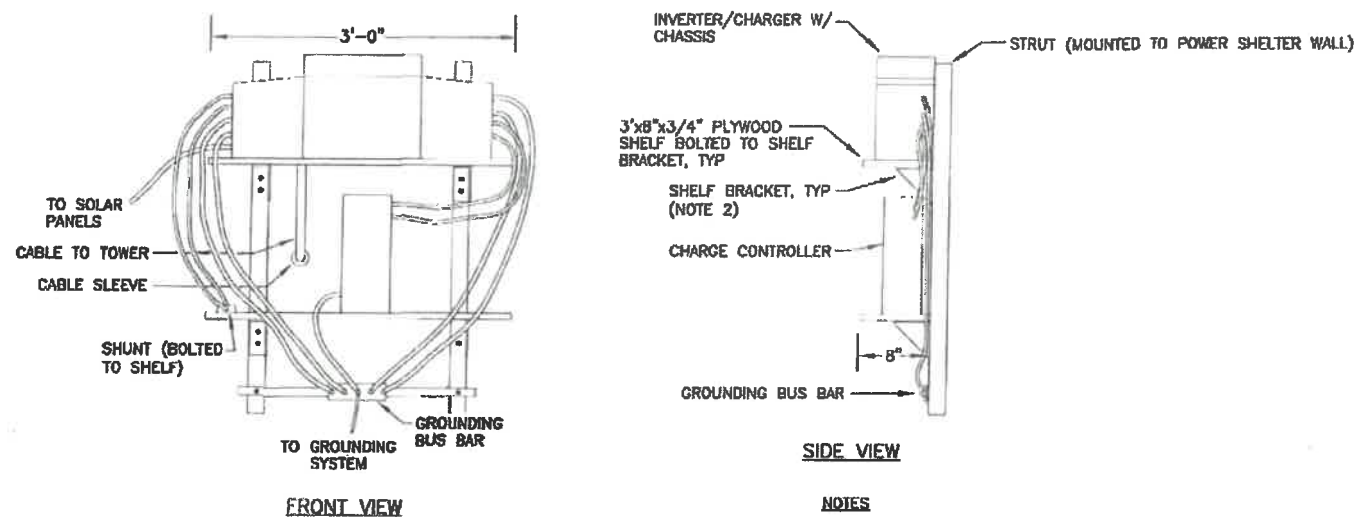

1 DETAIL - INVERTER/CHARGER STAND

NO SCALE

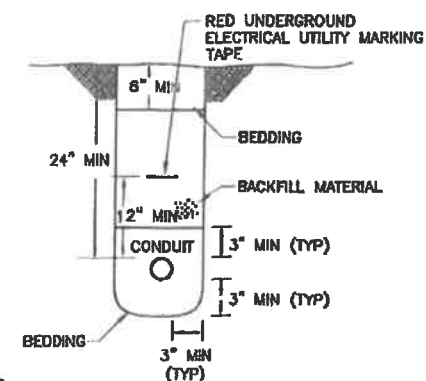


NOTES

1. CONDUIT SHALL BE RIGID STEEL WHEN BURIED LESS THAN 24 INCHES WHERE BEDROCK IS ENCOUNTERED.
2. CONDUIT SHALL BE ENCASED IN CONCRETE WHEN BURIED LESS THAN 6 INCHES WHERE BEDROCK IS ENCOUNTERED.
3. FIELD APPROVAL REQUIRED FOR SHALLOWER DEPTHS.

2 DETAIL - TRENCH

NO SCALE

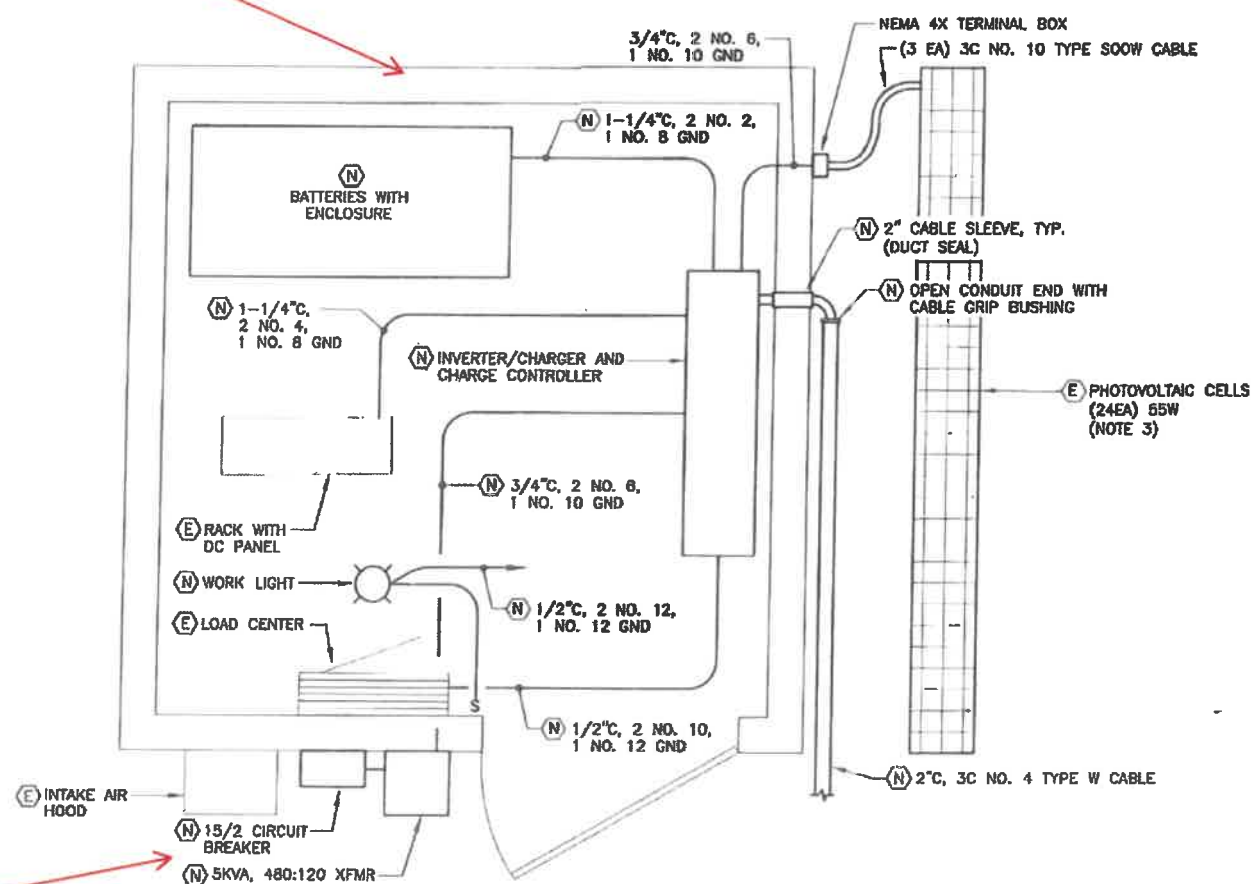

3 FLOOR PLAN - POWER SHELTER

NO SCALE



4 PHOTO - POWER SHELTER

NO SCALE

NOTES:

1. REMOVE THE EXISTING BATTERIES AND CHARGE CONTROLLERS.
2. UTILIZE ROCK ANCHORS AND WOOD BEAMS TO SUPPORT THE POWER SHELTER IN A LEVEL POSITION, SEE E6.
3. REPLACE SUPPORT ARMS ON BOTTOM OF SOLAR PANEL SUPPORT STRUCTURE WITH 3/8" THICK 2.5"x2.5" ANGLE STEEL, BOLTED TO SHELTER SUPPORT BEAM. LENGTH OF ANGLE STEEL SHALL BE LONG ENOUGH TO TILT THE SOLAR PANEL STRUCTURE TO 15 DEGREES FROM VERTICAL. DURING RE-LEVELING OF SHELTER, ALLOW THE SOLAR PANEL SUPPORT STRUCTURE TO REST WITH THE TOP SUPPORT ARMS LAYING ACROSS THE SHELTER ROOF.
4. RE-CIRCUIT SOLAR PANELS IN THREE SERIES-WIRED CIRCUITS PER THE SINGLE LINE DIAGRAM ON SHEET E4.

RELOCATED  
INSIDE


06/16 INCORPORATE POWER SHELTER  
STATE OF ALASKA  
DEPARTMENT OF TRANSPORTATION  
AND PUBLIC FACILITIES  
SGY: MINE MOUNTAIN  
REPEATER POWER  
UPGRADE SYSTEM

SITE PLAN  
& DETAILS

CHECKED BY: BCH  
DESIGNED BY: BCH/KHD  
DRAWN BY: KHD


PROJECT DESIGNATION  
0106(036)/80665

STATE	YEAR	SHEET
ALASKA	2016	E5 12

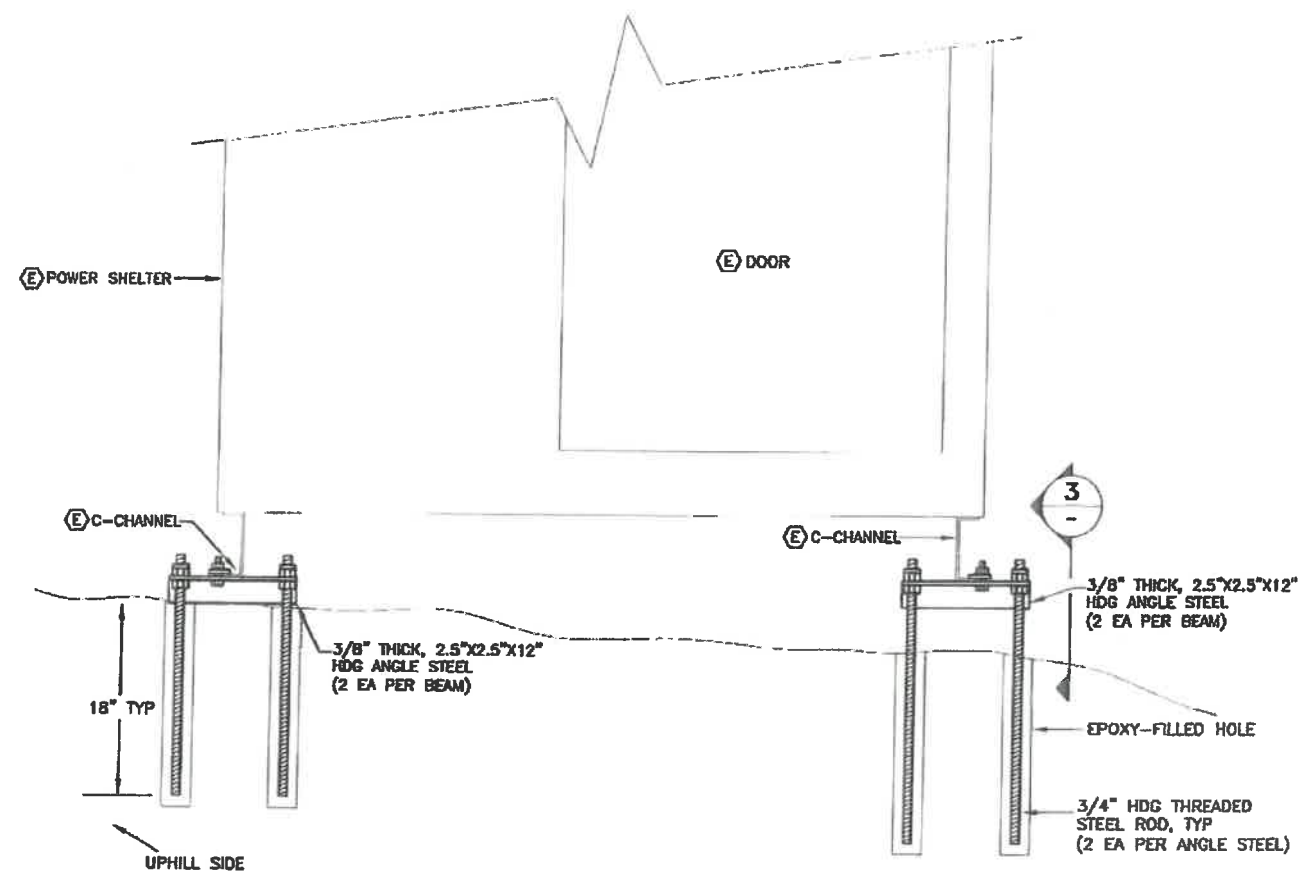


NOTE: THREADED ROD LENGTH AND LEVELING NUT POSITIONS AS REQUIRED TO LEVEL THE EXISTING SHELTER.

1 DETAIL - POWER SHELTER LEVELING  
NO SCALE

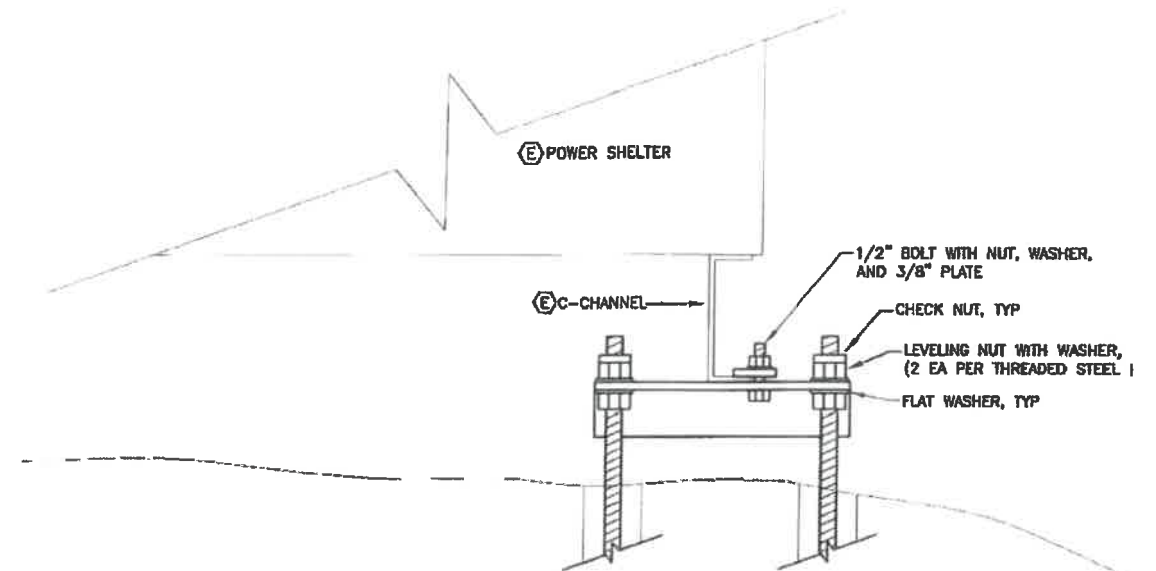

2 DETAIL - WOOD BEAM SIDE VIEW  
NO SCALE

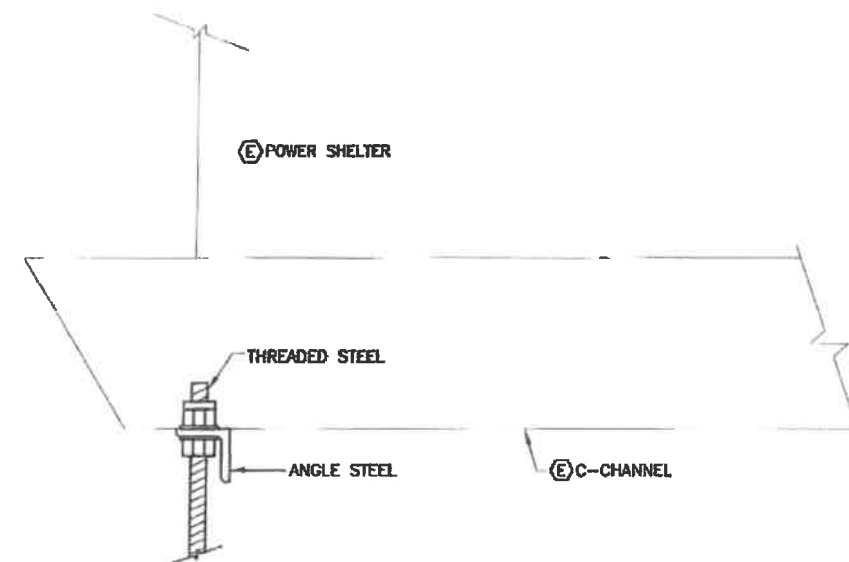

3 DETAIL - WOOD BEAM FRONT VIEW  
NO SCALE

08/16 POWER SHELTER DETAILS

STATE OF ALASKA  
DEPARTMENT OF TRANSPORTATION  
AND PUBLIC FACILITIES

SGY: MINE MOUNTAIN  
REPEATER POWER  
SYSTEM UPGRADE



SITE PLAN  
& DETAILS

CHECKED BY: BCH  
DESIGNED BY: BCH/KHD  
DRAWN BY: KHD

PROJECT DESIGNATION  
0100(038)/80665

STATE	YEAR	SHEET
ALASKA	2015	E6 12



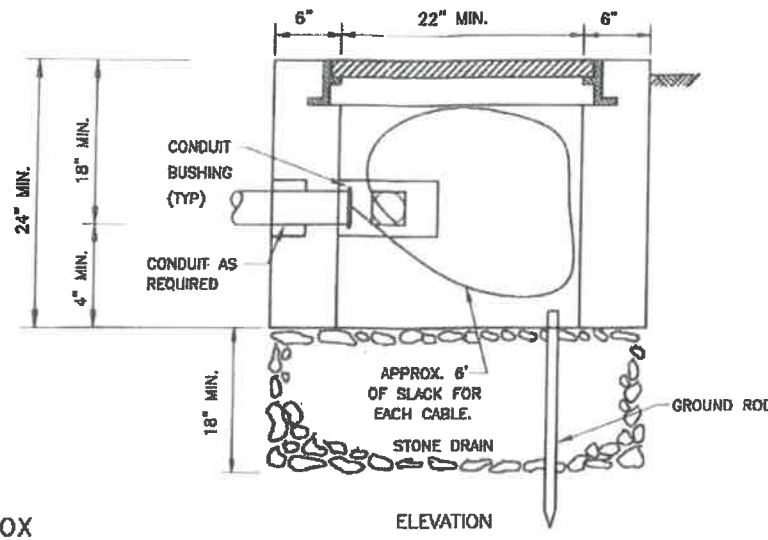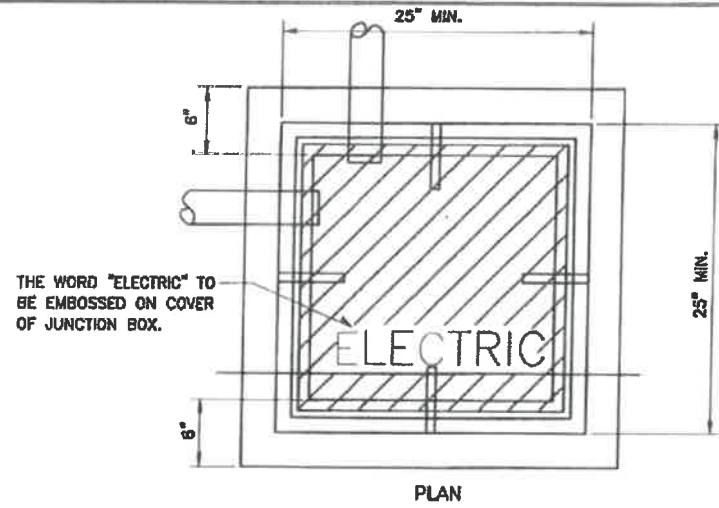


GENERAL NOTES:

1. EACH FRAME AND COVER FOR TYPE II JUNCTION BOXES SHALL BE OF CAST IRON FOR LIGHT DUTY USE WITH A MINIMUM WEIGHT OF 210 POUNDS.
2. ALL METAL CONDUITS SHALL BE BONDED TO FORM A CONTINUOUS ELECTRICALLY SECURE SYSTEM WITH THE GROUND AT THE GROUNDING ROD IN THE JUNCTION BOX.
3. ALL JUNCTION BOX COVERS SHALL BE BONDED TO GROUNDING ROD WITH COPPER BRAID OF #8 AWG CROSS SECTION. THE LENGTH OF BRAID SHALL BE 5 FEET.
4. ALL CONDUITS SHALL BE GROUTED IN KNOCKOUT SECTIONS IN ACCORDANCE WITH THE ALASKA SPECIFICATIONS FOR HIGHWAY CONSTRUCTION, LATEST EDITION.
5. JUNCTION BOXES SHALL BE SET FLUSH WITH THE SURROUNDING SURFACE.
6. ALL CONDUITS SHALL ENTER JUNCTION BOX THROUGH SIDES ONLY.

SEE ATTACHED  
ONE LINE AS-BUILT  
FOR CONDUIT AND  
CONDUCTOR SIZES

1 DETAIL - TYPE II JUNCTION BOX  
ADOT & PF STANDARD DETAIL L23.01 WITH MODIFICATIONS NO SCALE

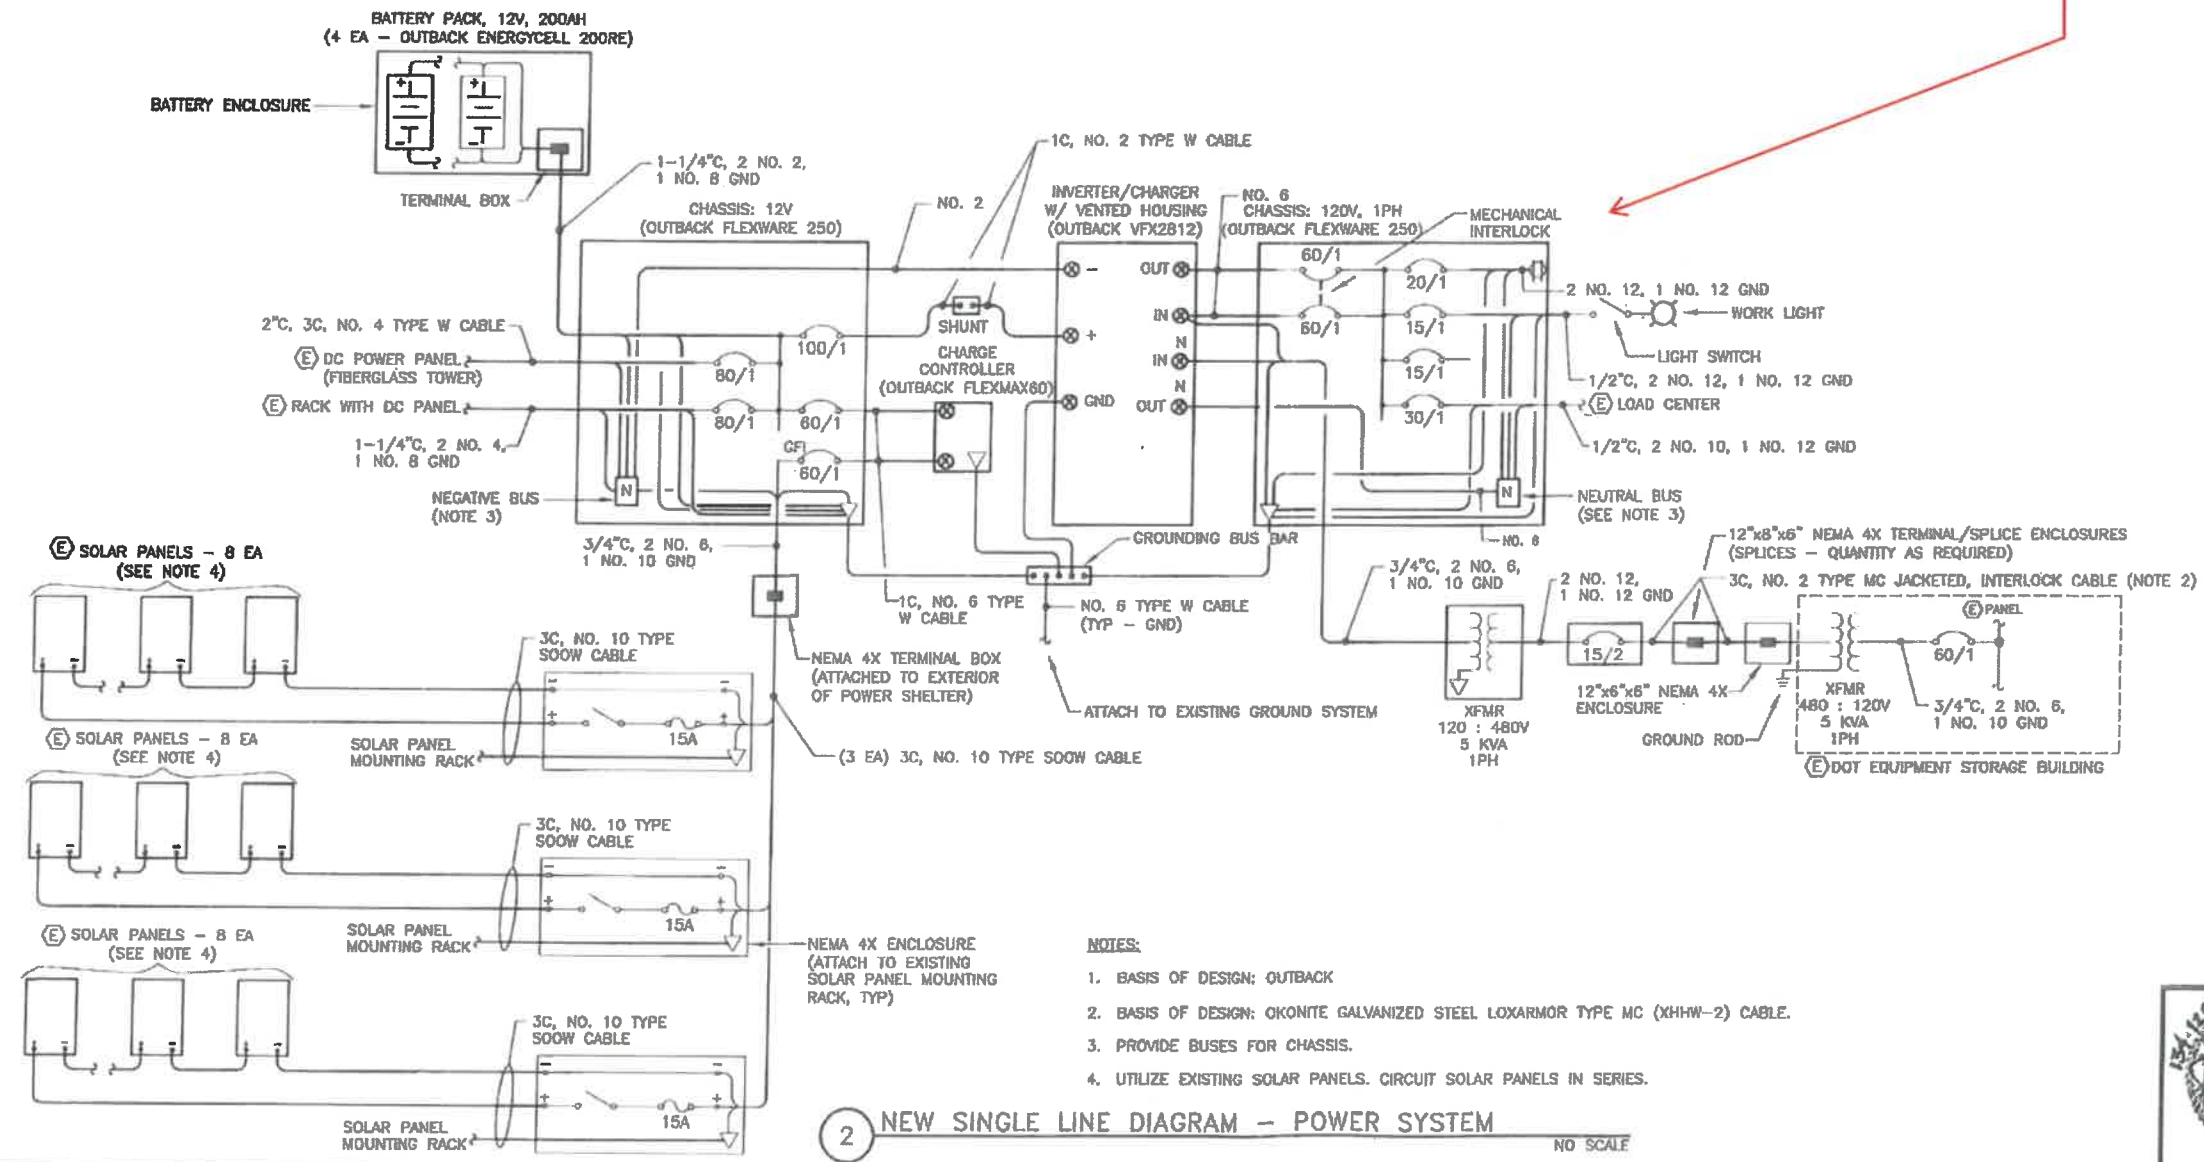

NOTES:

1. BASIS OF DESIGN: OUTBACK
2. BASIS OF DESIGN: OKONITE GALVANIZED STEEL LOXARMOR TYPE MC (XHHW-2) CABLE.
3. PROVIDE BUSES FOR CHASSIS.
4. UTILIZE EXISTING SOLAR PANELS. CIRCUIT SOLAR PANELS IN SERIES.

2 NEW SINGLE LINE DIAGRAM - POWER SYSTEM NO SCALE

4 STRINGS

06/16	INCORPORATE POWER SHELTER	
STATE OF ALASKA DEPARTMENT OF TRANSPORTATION AND PUBLIC FACILITIES		
SGY: MINE MOUNTAIN REPEATER POWER SYSTEM UPGRADE		
SITE PLAN & DETAILS		
CHECKED BY: BCH		
DESIGNED BY: BCH/KHD		
DRAWN BY: KHD		
PROJECT DESIGNATION		
0106(036)/80885		
STATE	YEAR	SHEET
ALASKA	2015	E7 12





# MEINE MOUNTAIN / LINE DRAWING.

**CHATHAM ELECTRIC**  
P.O. BOX 34977 • JUNEAU, AK 99803  
(907) 789-9899 • FAX (907) 789-6954

JOB


DATE

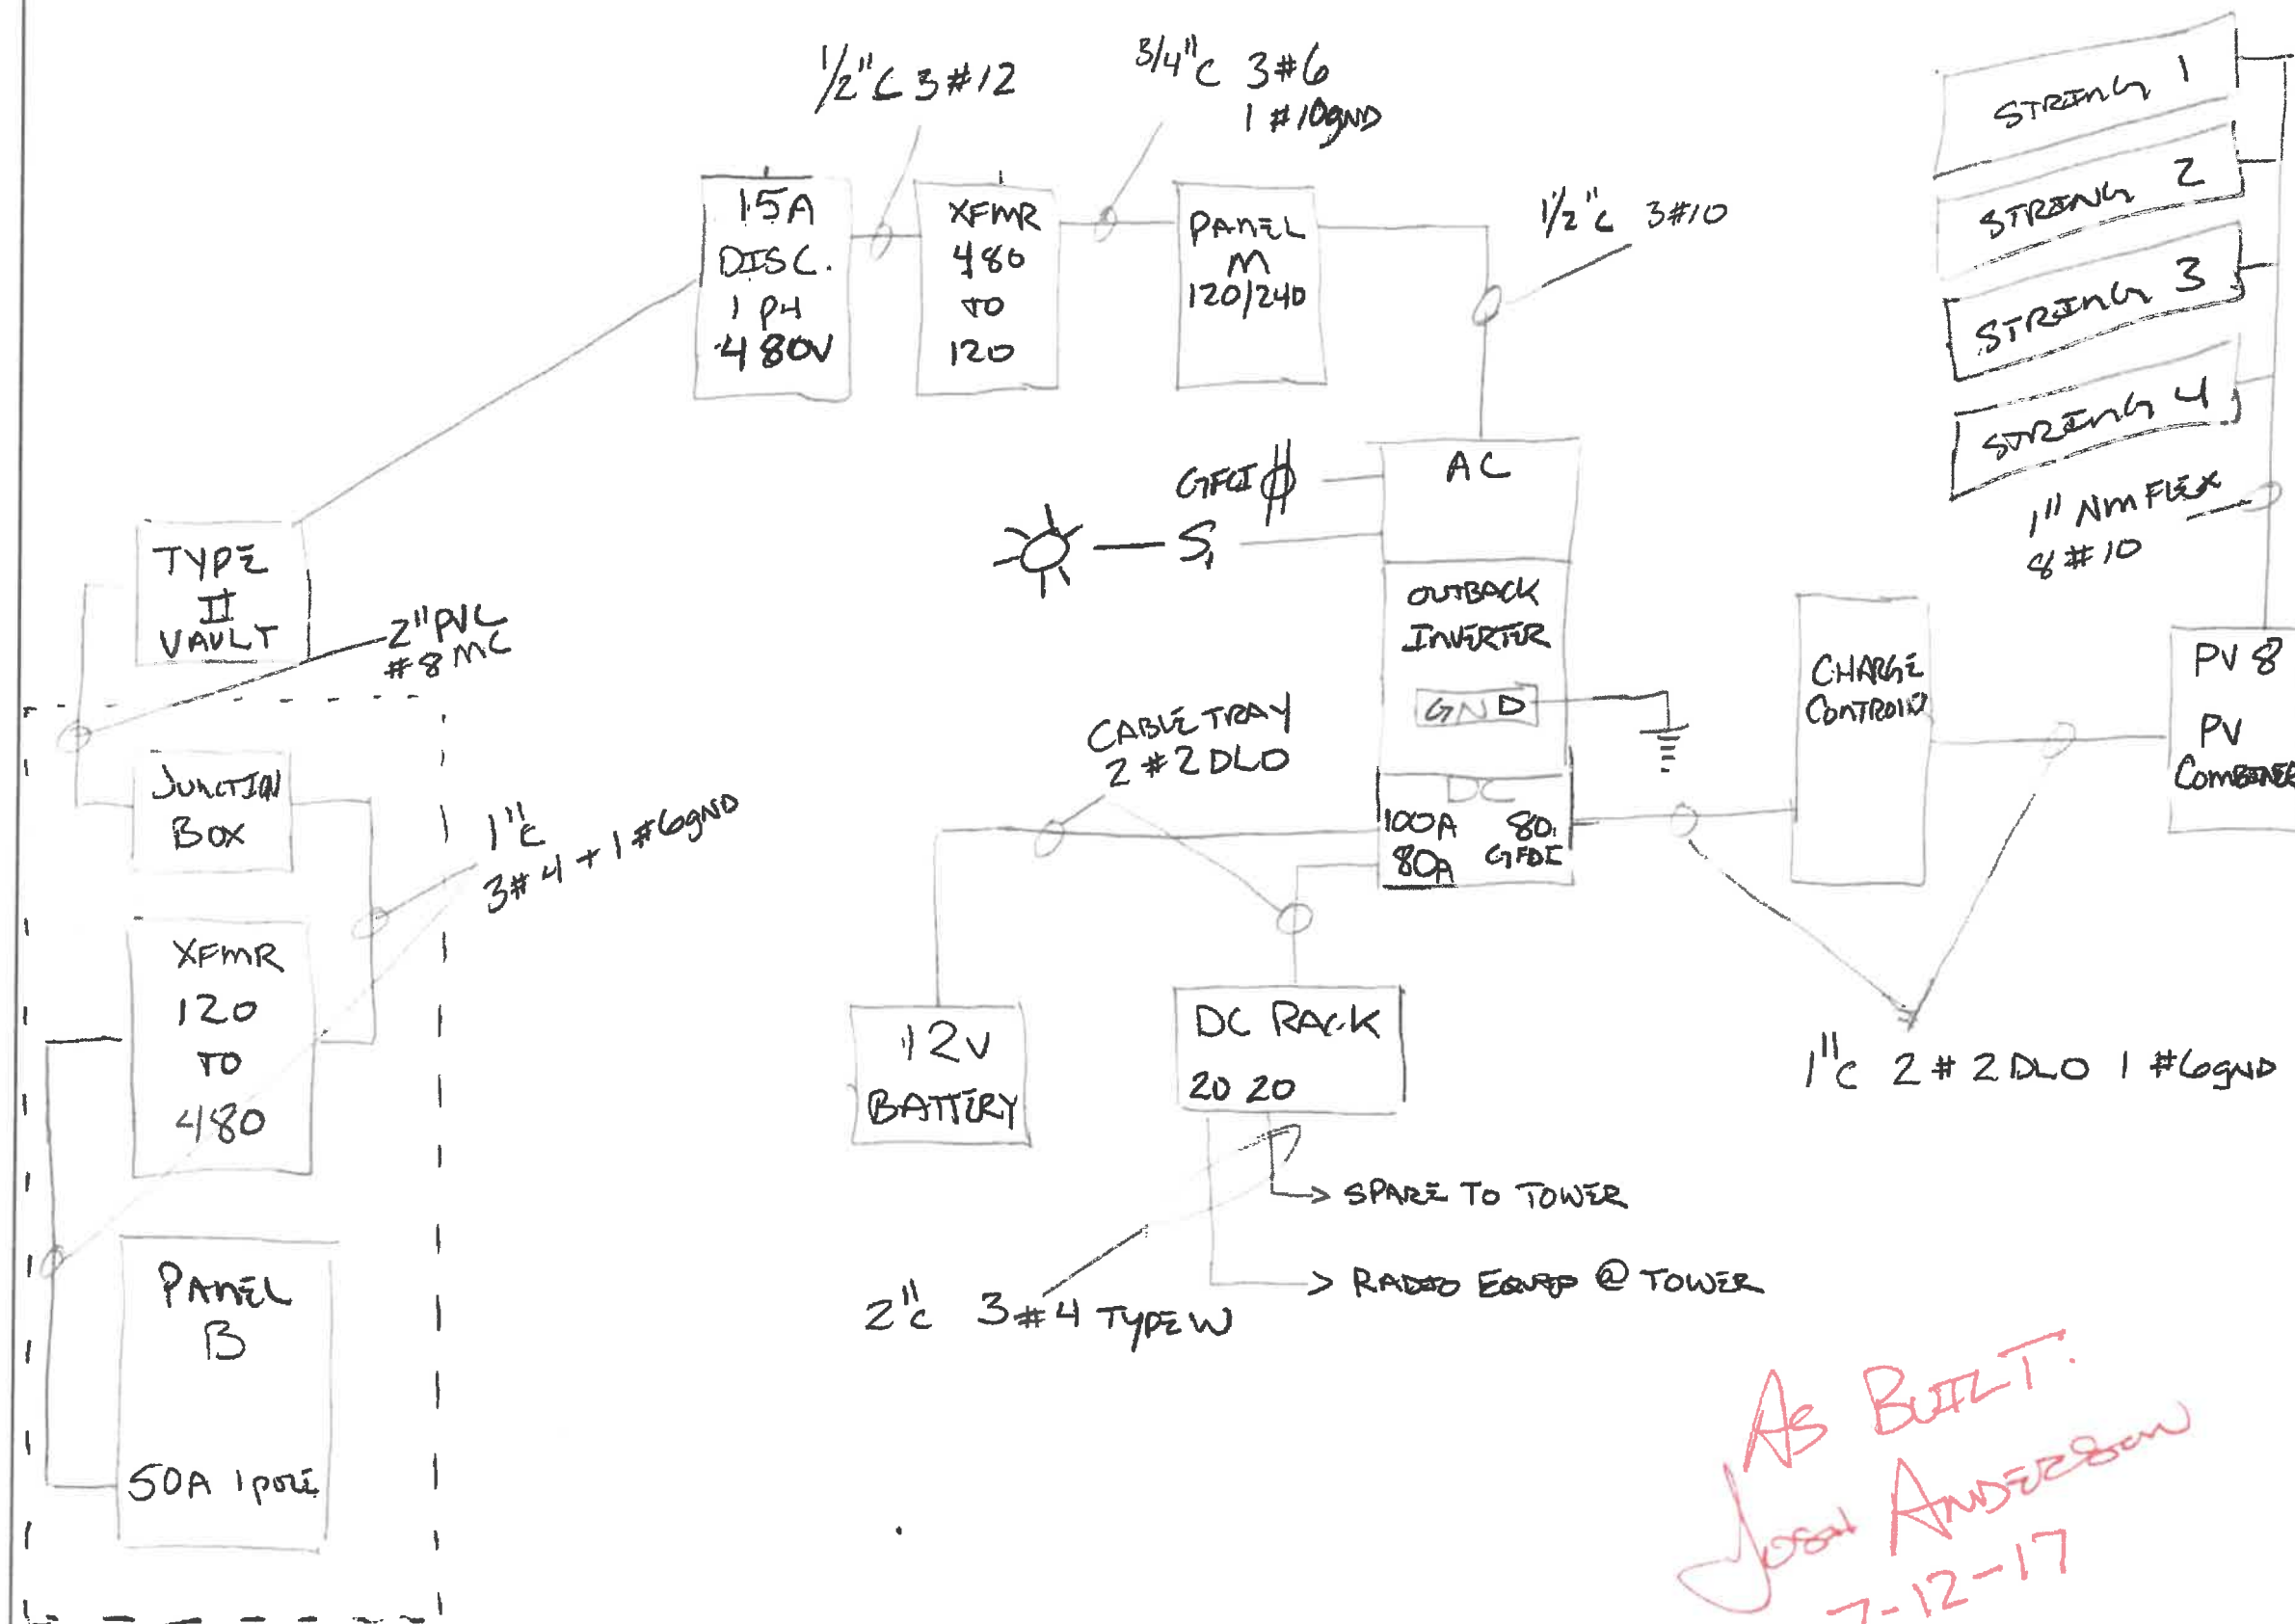

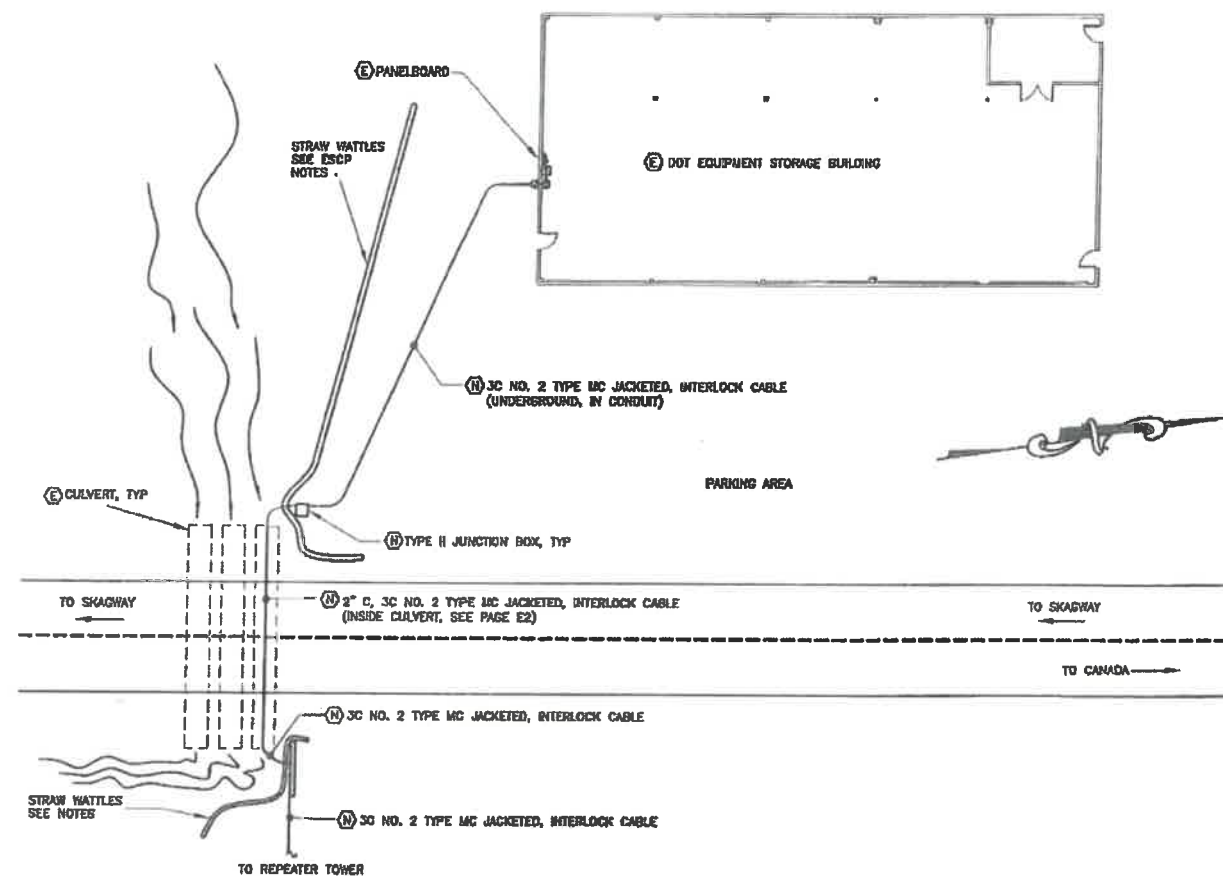


**1 SITE PLAN / EROSION & SEDIMENT CONTROL PLAN**


NO SCALE

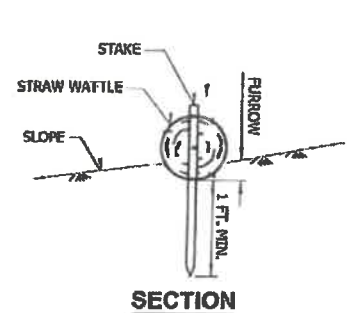

**SECTION**

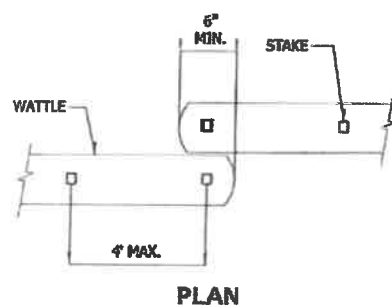


**PLAN**

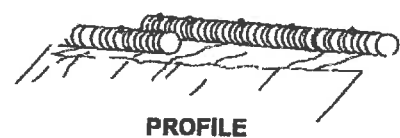


**PROFILE**


**TYPE 1**

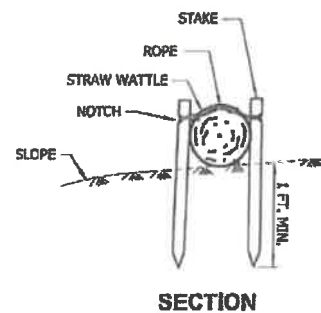

**SECTION**

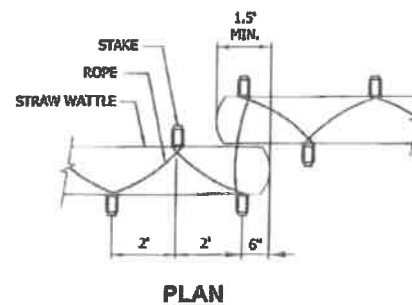

**PLAN**

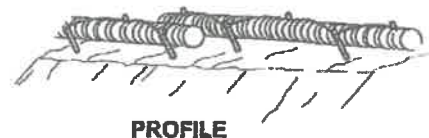


**PROFILE**

**TYPE 2**

**3 STRAW WATTLE INSTALLATION DETAIL**

NO SCALE

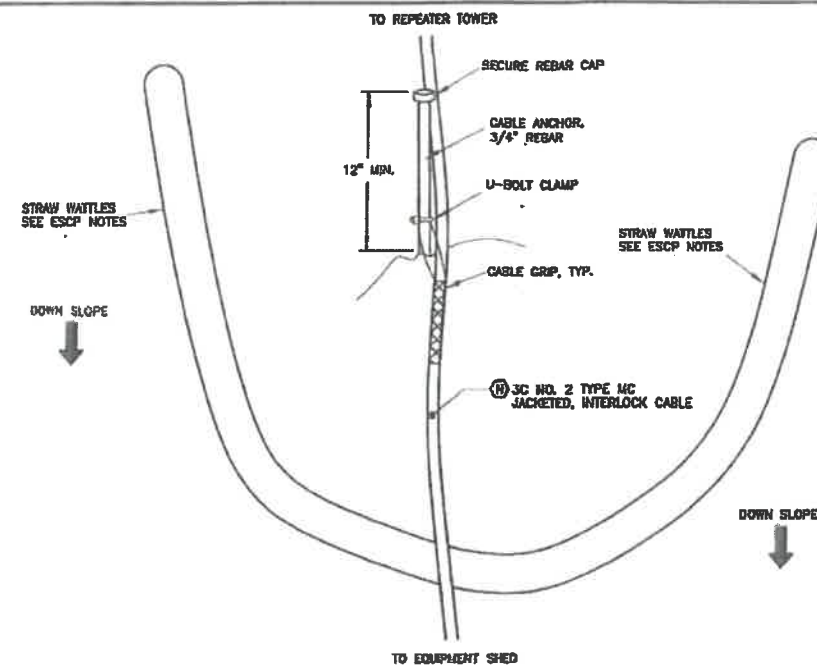


**SPLICE & ANCHOR  
STRAW WATTLE INSTALLATION DETAIL**


NO SCALE

**ESCP NOTES**


1. INSTALL STRAW WATTLE BEFORE BEGINNING CONSTRUCTION ACTIVITIES.
2. EXTEND STRAW WATTLE BEYOND LOWER EDGES OF FILL OR DISTURBANCE.
3. THE LOCATIONS OF TEMPORARY EROSION & SEDIMENT POLLUTION CONTROLS ARE ONLY RECOMMENDATIONS. IT IS THE RESPONSIBILITY OF THE CONTRACTOR TO PREPARE AND IMPLEMENT A WQCP ACCORDING TO SECTION 641 OF THE SPECS.
4. ADDITIONAL EROSION AND SEDIMENT POLLUTION CONTROL DEVICES MAY NEED TO BE ADDED AT THE DISCRETION OF THE PROJECT ENGINEER.
5. LAP ENDS OF STRAW WATTLE TO PREVENT SEDIMENT FROM SNEAKING THROUGH.
6. ANCHOR STRAW WATTLE EVERY FOUR FEET OR AS NEEDED TO SECURE FIRMLY IN PLACE PROVIDING CONTINUOUS GROUND CONTACT.
7. EROSION CONTROL MEASURES WILL BE EVALUATED BY THE ENGINEER BASED ON EFFECTIVENESS. THOSE FOUND INEFFECTIVE MUST BE REPLACED OR REPAIRED WITHIN 24 HOURS FOLLOWING NOTIFICATION.
8. MAINTAIN AND MONITOR EROSION AND SEDIMENT POLLUTION CONTROL DEVICES ON A DAILY BASIS.
9. REMOVE EROSION AND SEDIMENT POLLUTION CONTROL DEVICES AFTER CONSTRUCTION IS COMPLETE.

DO NOT SCALE FROM THESE DRAWINGS USE DIMENSIONS

CHECKED BY: BCH  DESIGNED BY: KID DRAWN BY: REJ PATH: F:\PROJECTS\194 STATE OF ALASKA DOT\PI1254 MINE MOUNTAIN REPEATER MODIFIED DESIGN\DRAWING\SIWORKING TAB: P1 Friday, July 01, 2016 11:05:48 AM KYLE DRAPEAUX		STATE OF ALASKA DEPARTMENT OF TRANSPORTATION & PUBLIC FACILITIES SOUTHEAST REGION <b>SGY: MINE MOUNTAIN          REPEATER POWER          SYSTEM UPGRADE</b> <b>SITE PLAN/ESCP</b>							
REVISIONS <table border="1"> <thead> <tr> <th>NO.</th> <th>DATE</th> <th>DESCRIPTION</th> </tr> </thead> <tbody> <tr> <td> </td> <td> </td> <td> </td> </tr> </tbody> </table>		NO.	DATE	DESCRIPTION				PROJECT DESIGNATION <b>0106(036)/80665</b> YEAR <b>2015</b> SHEET NO. <b>P1</b> TOTAL SHEETS <b>12</b>	
NO.	DATE	DESCRIPTION							

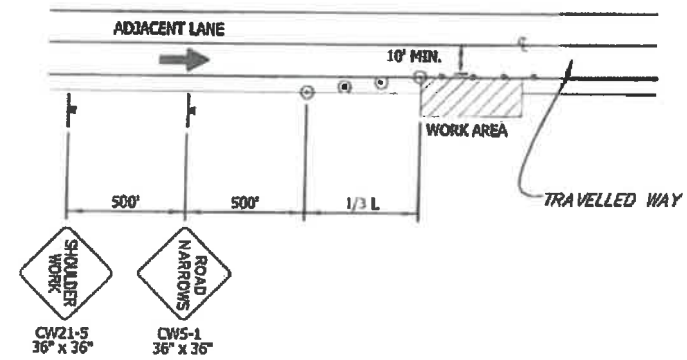

### SHOULDER WORK

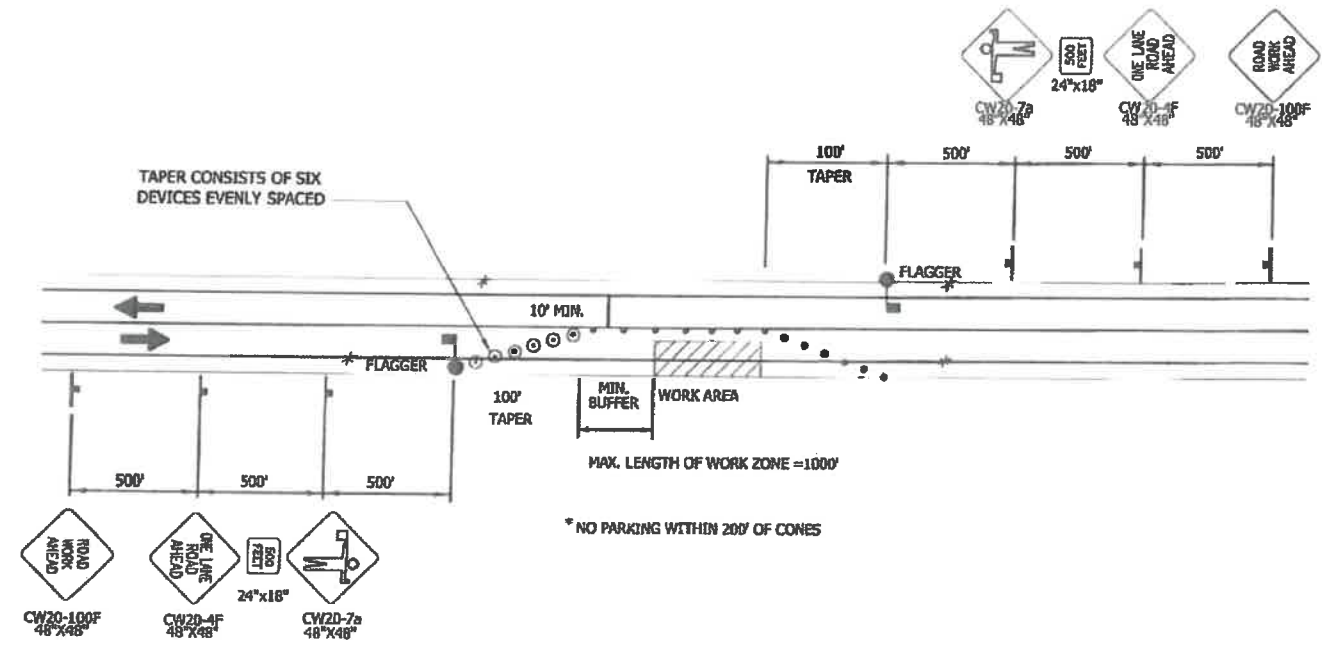

### SINGLE LANE CLOSURE TWO LANE ROAD

TRAFFIC CONTROL PLAN SET UP TABLE								
SPEED (MPH)	LANE WIDTH (ft)			LANE WIDTH (ft)			SPACING (ft)	
	10	11	12	10	11	12	Straight	Curve
	Minimum Taper Length (ft)			Minimum Number of Devices			Buffer (ft)	Buffer (ft)
40	270	285	320	5	8	9	40	80
45	460	495	540	11	12	13	45	90
50	500	550	600	11	12	13	50	100
55	550	605	660	11	12	13	55	110

LEGEND

..... SIGN

..... CONE

..... DRUM

#### NOTES:

1. MINIMUM OF ONE LANE SHALL REMAIN OPEN AT ALL TIMES IN WORK AREAS.
2. TEMPORARY DRIVING LANES SHALL HAVE A MINIMUM WIDTH OF 10'-0".
3. THE CONTRACTOR SHALL ORGANIZE CONSTRUCTION OPERATIONS SO THE TOTAL OF ALL STOPPAGES EXPERIENCED BY A VEHICLE TRAVELING THROUGH THE PROJECT DOES NOT EXCEED FIVE MINUTES.
4. CONSTRUCTION SIGNING SHALL BE IN PLACE ONLY WHEN THE CONDITIONS EXIST FOR WHICH THE SIGNS ARE INTENDED.
5. CHANNELIZATION DEVICES IF USED AT NIGHT SHALL BE LIT IN ACCORDANCE WITH THE ALASKA TRAFFIC MANUAL.
6. IT IS THE INTENT OF THIS TRAFFIC CONTROL PLAN (TCP) TO ILLUSTRATE SOME, NOT ALL, OF THE TRAFFIC CONTROL SETUPS WHICH WILL BE REQUIRED ON THIS PROJECT. ALL TCPs SHALL BE CREATED BY THE CONTRACTOR AND SUBMITTED TO THE ENGINEER FOR APPROVAL.

DO NOT SCALE FROM THESE DRAWINGS USE DIMENSIONS

CHECKED BY: BCH

DESIGNED BY: KHD

DRAWN BY: REJ

PATH: F:\PROJECTS\134 STATE OF ALASKA DOT\PF123A MINE MOUNTAIN REPEATER MODIFIED DESIGN\DRAWINGS\WORKING

TAB: T1 Friday, July 01, 2016 11:06:13 AM

REVISIONS

NO.	DATE	DESCRIPTION
-----	------	-------------

STATE OF ALASKA

DEPARTMENT OF TRANSPORTATION & PUBLIC FACILITIES

SOUTHEAST REGION

SGY: MINE MOUNTAIN REPEATER POWER SYSTEM UPGRADE

TRAFFIC CONTROL

PROJECT DESIGNATION

0106(036)/80665

YEAR

2015

SHEET NO.

T1

TOTAL SHEETS

12